


T. 4 S., R. 2 E., W.M.

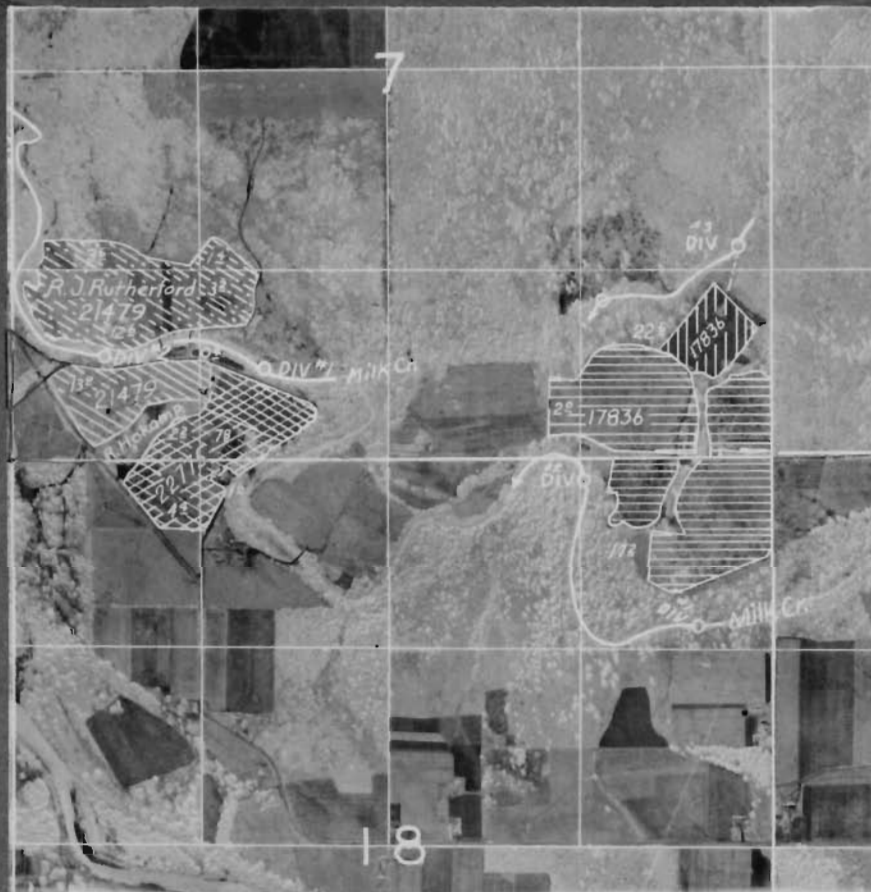

**FINAL PROOF SURVEY**  
UNDER

Application Nos.	Permit Nos.
17836	13699
21479	16847
22775	17940

IN NAME OF  
HENRY & PEARL FREEMAN

HERBERT F. & ROVILLA HOKAMP & RUSSELL J. RUTHERFORD  
Surveyed May 26 1953, by H. L. Coffman

DFK-3D-121