


T. 1 S., R. 3 E., W.M.

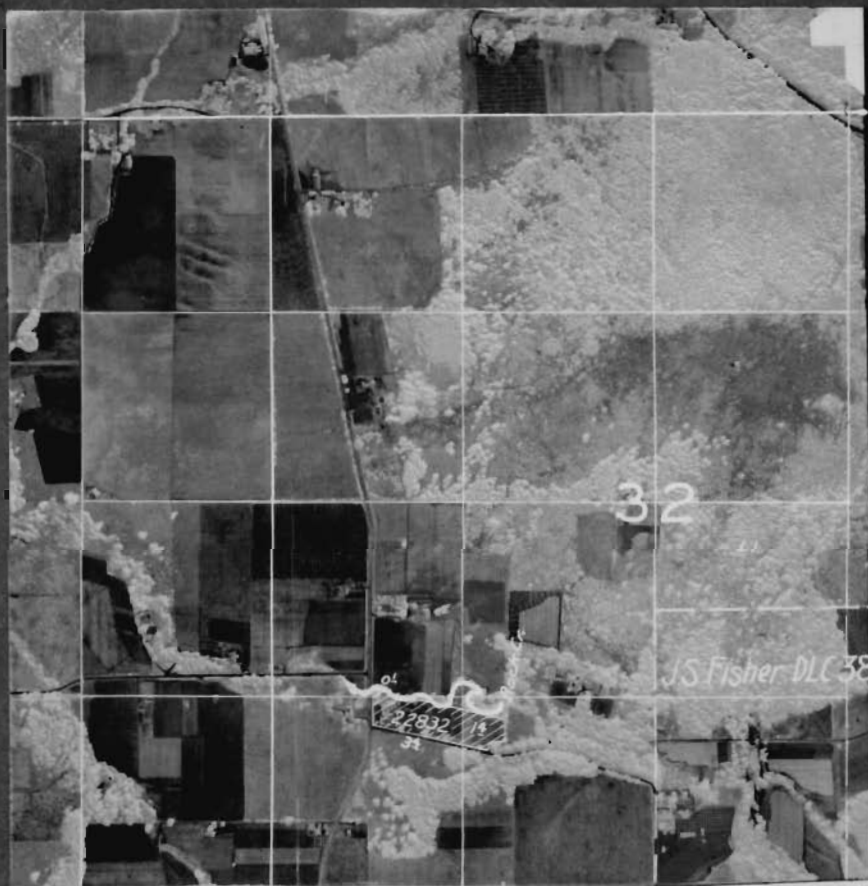

FINAL PROOF SURVEY

UNDER

Application No. 22832 Permit No. 18045

IN NAME OF

HAROLD H. ALEN

Surveyed July 2 19 53, by H. L. Coffman