


T4 & 5S., R. 3 E., W.M.

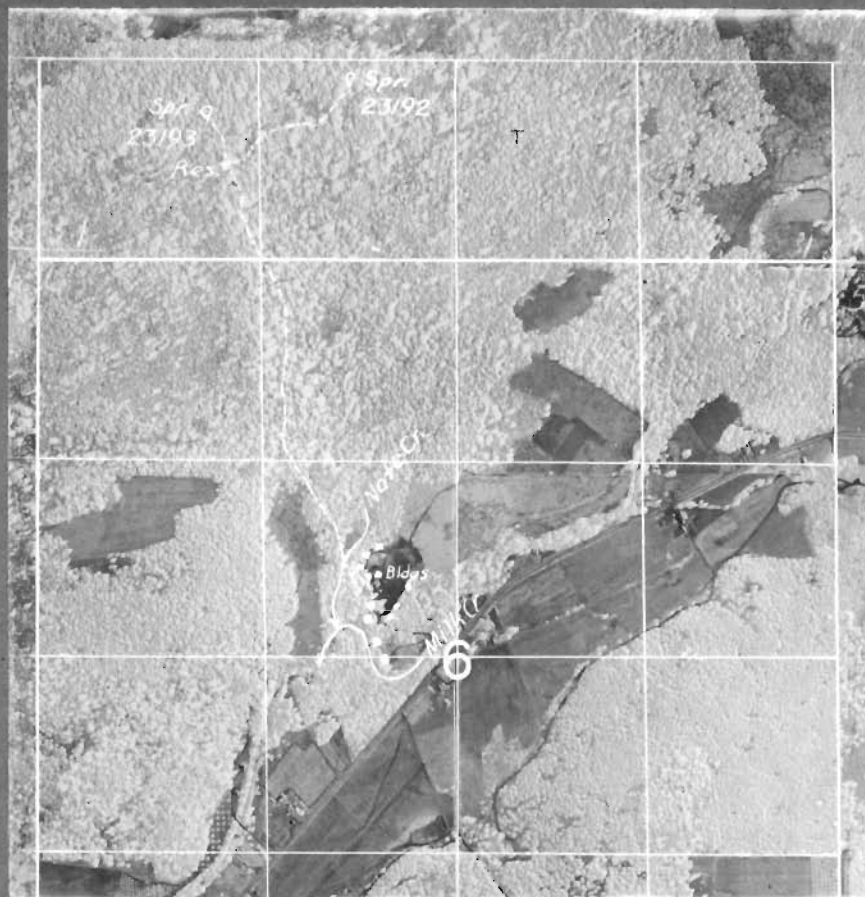

FINAL PROOF SURVEY

UNDER

Application No. 23192 Permit No. 18258
23193 18259

IN NAME OF

CONGREGATIONAL CONFERENCE OF OREGON, A Corporation

Surveyed July 6 19 53, by T. Jones

DFK-1D-92