


# T.2NR.2W.W.M.

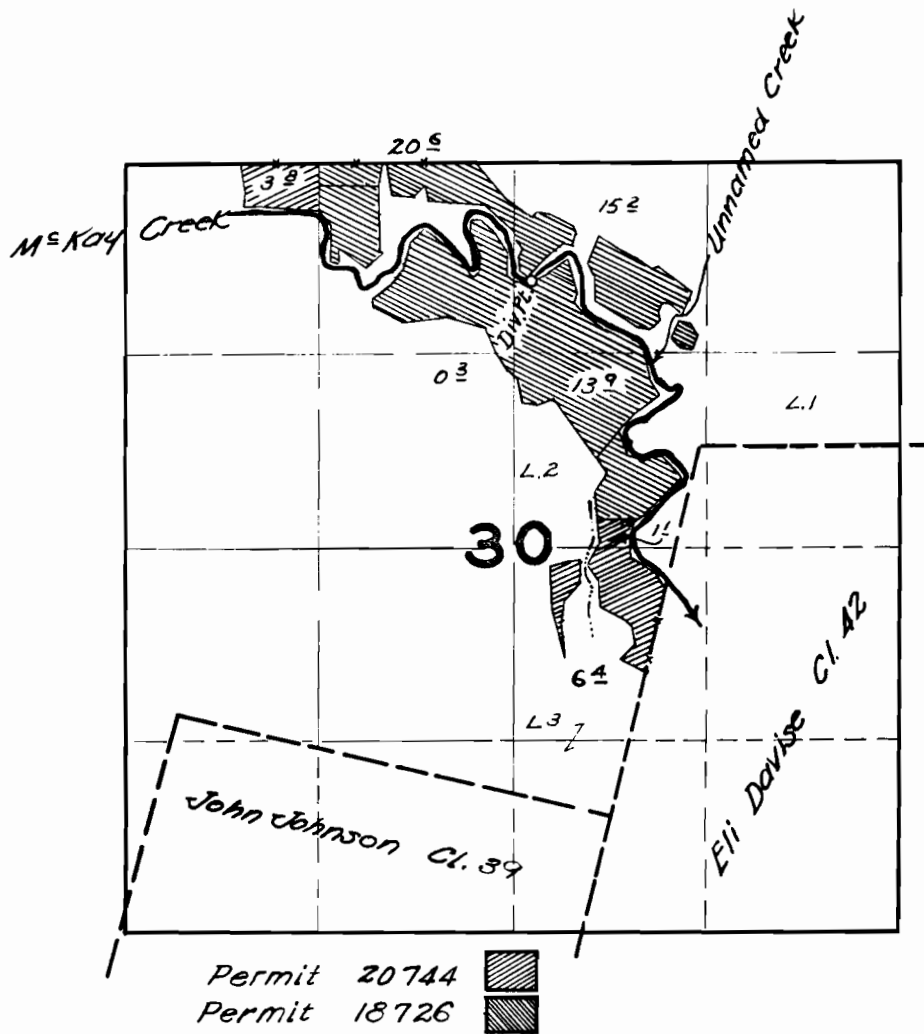

## FINAL PROOF SURVEY

UNDER

26460

20744

Application No. 23713

Permit No. 18726

IN NAME OF

FRANK E. DIAZ

Surveyed 6 / 20 1908, by H. L. GARDNER