


T.2NR.2W.W.M.

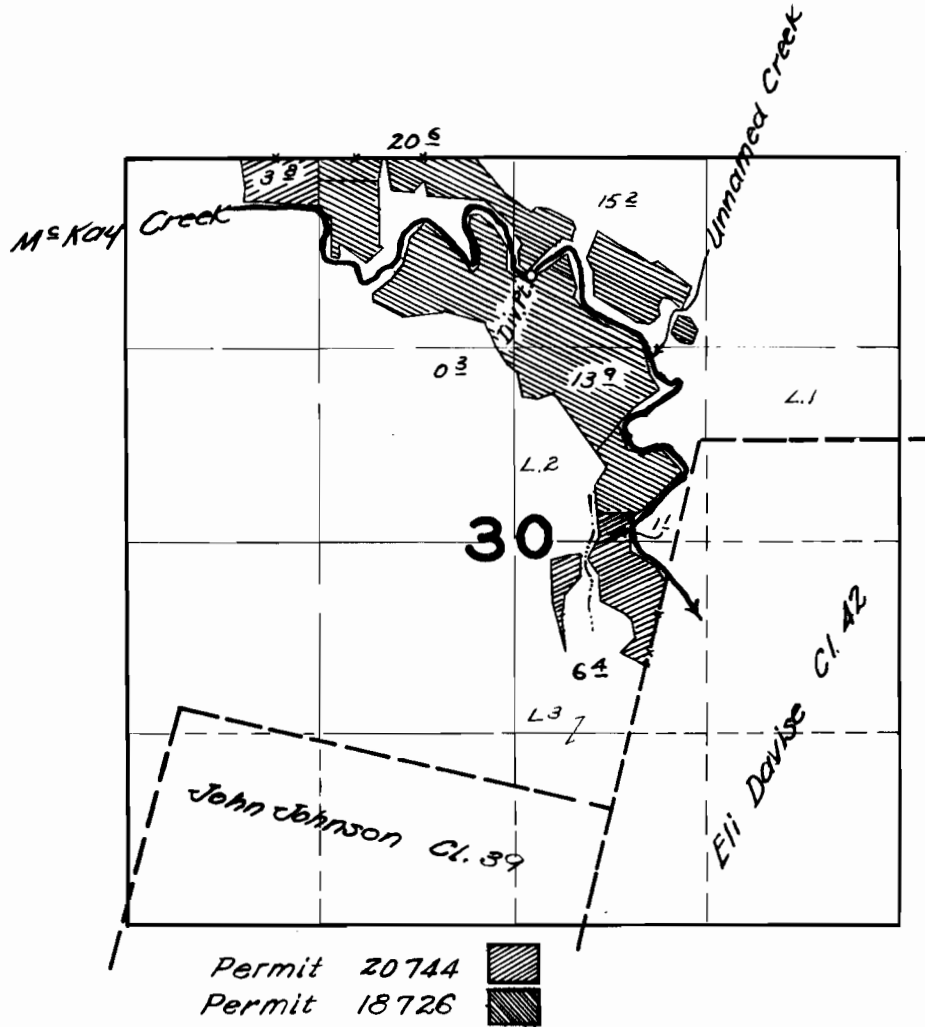

FINAL PROOF SURVEY

UNDER

26460

20744

Application No. 23713 Permit No. 18726

IN NAME OF

FRANK H. PLAISTAD

Surveyed 6 / 20 1952, by H. L. COFFMAN

1952 D