


# T.5S.R.4W.W.M.

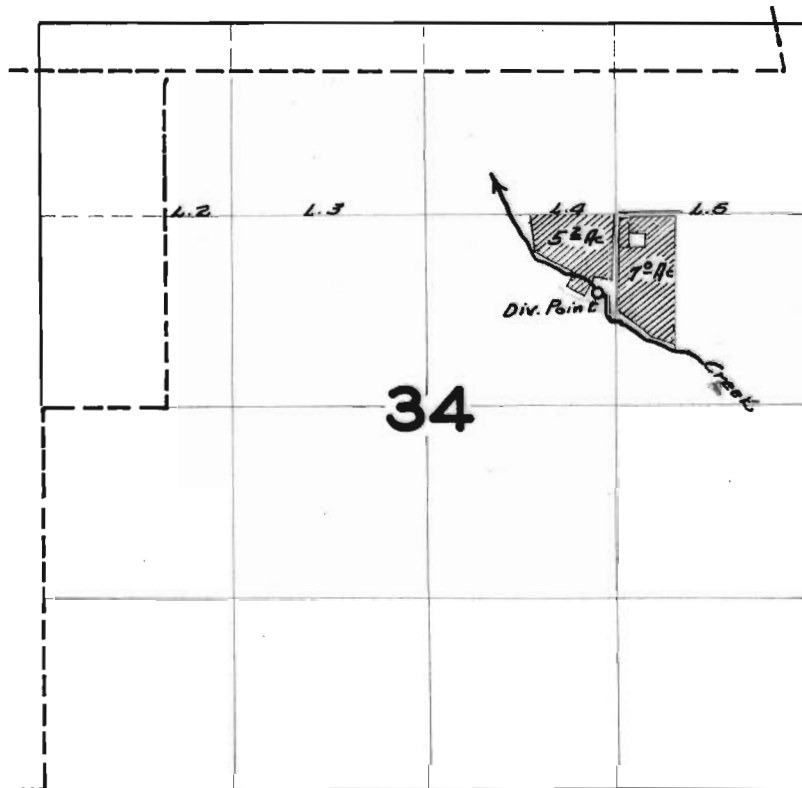

## FINAL PROOF SURVEY UNDER

Application No. 22524 Permit No. 17745  
IN NAME OF

HOWARD DAVIDSON

Surveyed 9 / 12 1951, by H.L. COFFMAN