


21991
T. 3 S., R. 2 E., W.M.

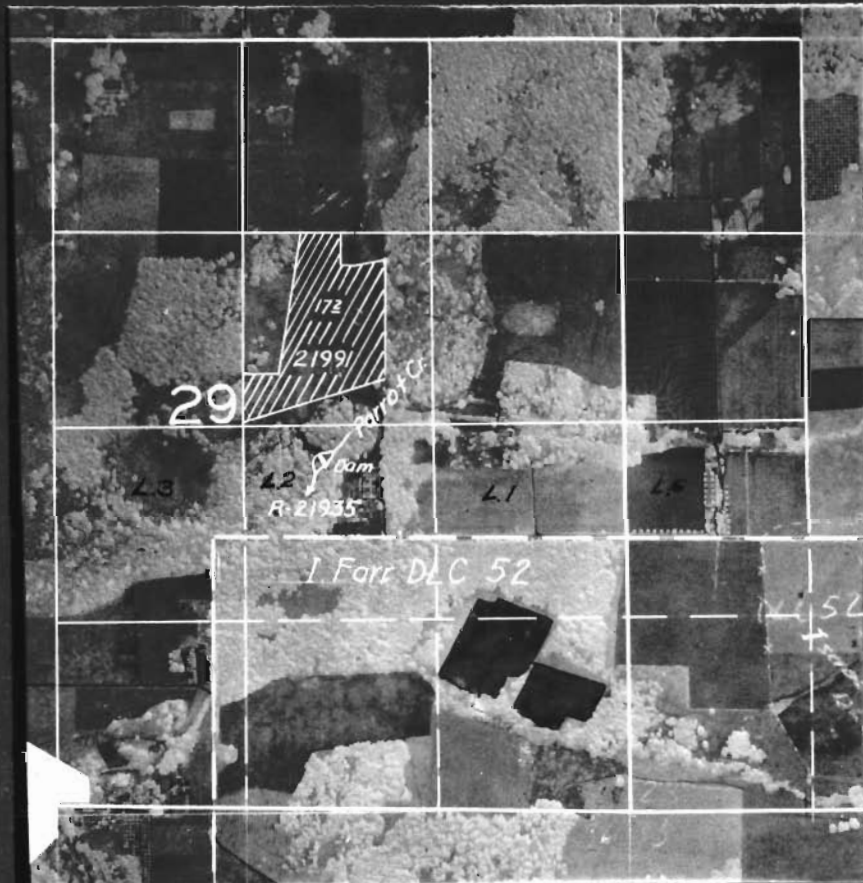

FINAL PROOF SURVEY

UNDER

R-21935

R-851

Application No. 21991 Permit No. 17315

IN NAME OF

ARTHUR NELSON

Surveyed May 18 1953, by H. L. Coffman

DFK-3D-153