


22595-R-23606-23607

T. 3 S., R. 2 E., W.M.

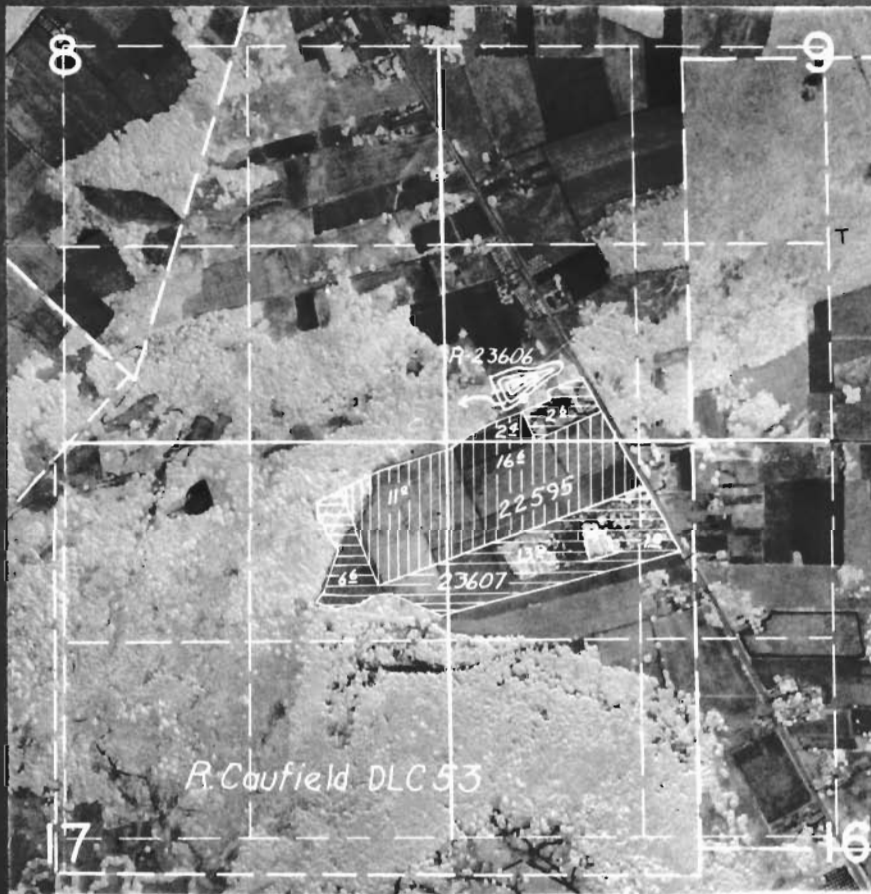

**FINAL PROOF SURVEY**  
 UNDER

Application Nos.	Permit Nos.
22595	17917
R-23606	R-976
23607	18804

IN NAME OF  
 A. GUNTHER

Surveyed May 20, 19 53, by H. L. Coffman

DFK-3D-151