


T. 3 S., R. 2 E., W.M.

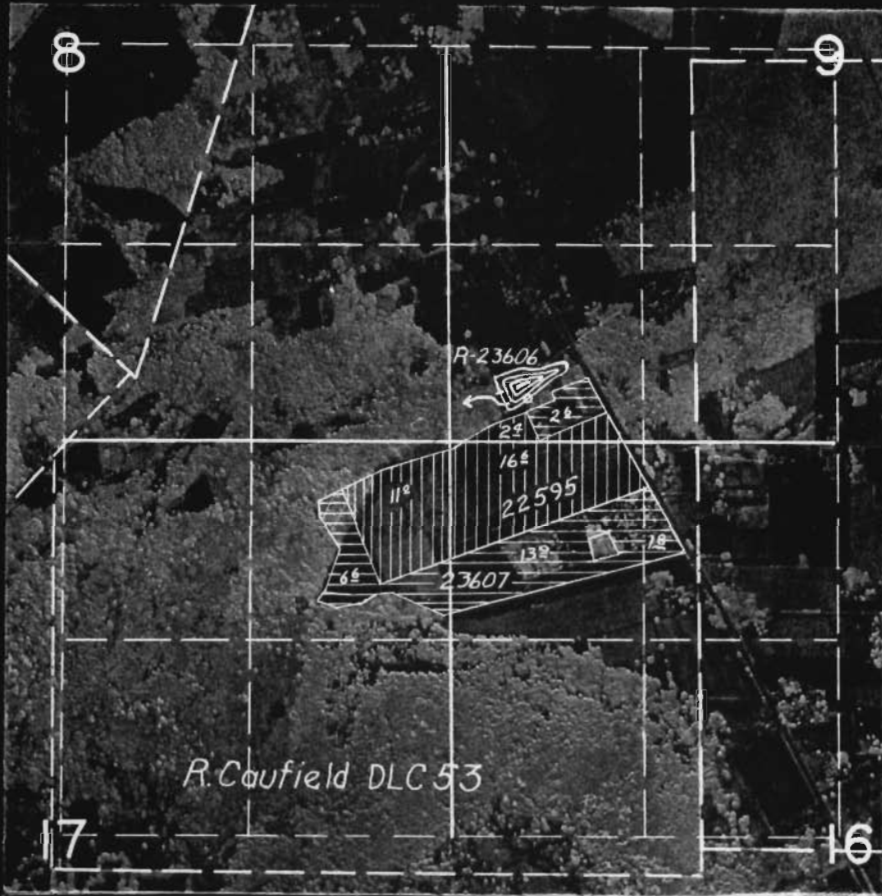

**FINAL PROOF SURVEY**  
UNDER

| Application Nos. | Permit Nos. |
|------------------|-------------|
| 22595            | 17917       |
| R-23606          | R-976       |
| 23607            | 18804       |

IN NAME OF  
A. GUNTHER

Surveyed May 20 1953, by H. L. Coffman

DFK-3D-151