


T.20S.R.4W.W.M.

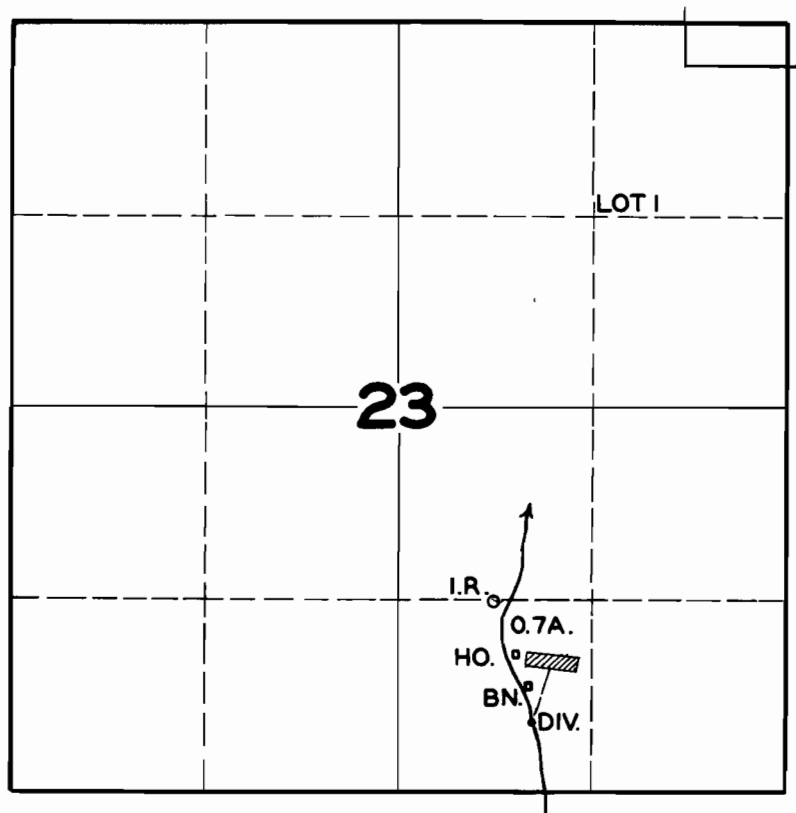

FINAL PROOF SURVEY
UNDER

Application No. **17402** Permit No. **13148**
IN NAME OF

MARION F. JOHNSON

Surveyed **JULY 20 1948**, by **JAS. E. BUNNELL**