


T.7S. R.3W.W.M.

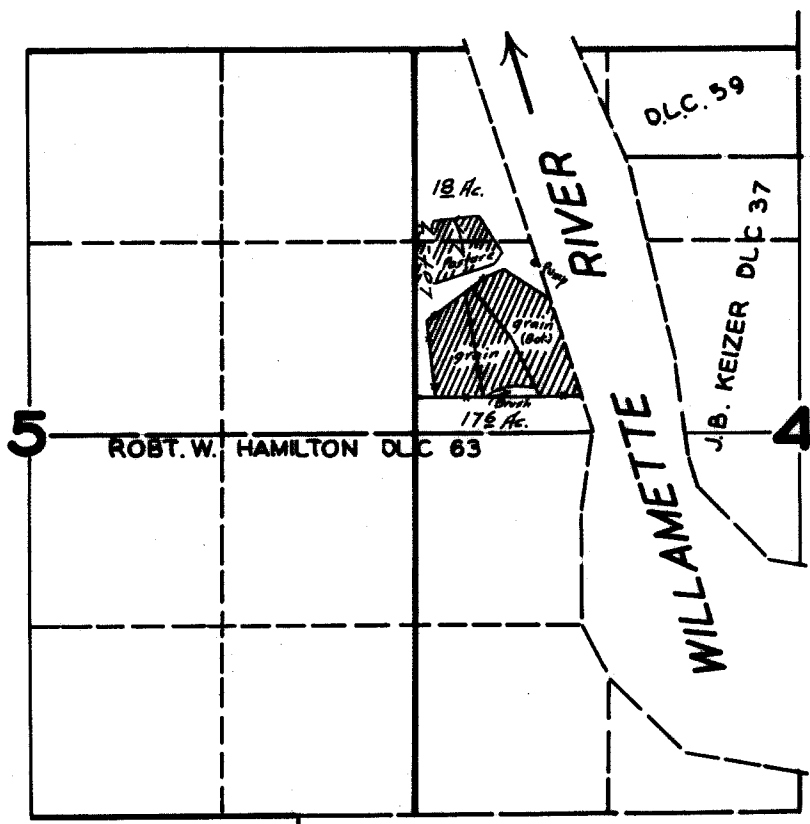

FINAL PROOF SURVEY UNDER

Application No. 18042 Permit No. 13711

IN NAME OF

F. J. WOELK

Surveyed JULY 20 1944, by [Signature]