


**T.6S.R.1W.W.M.**

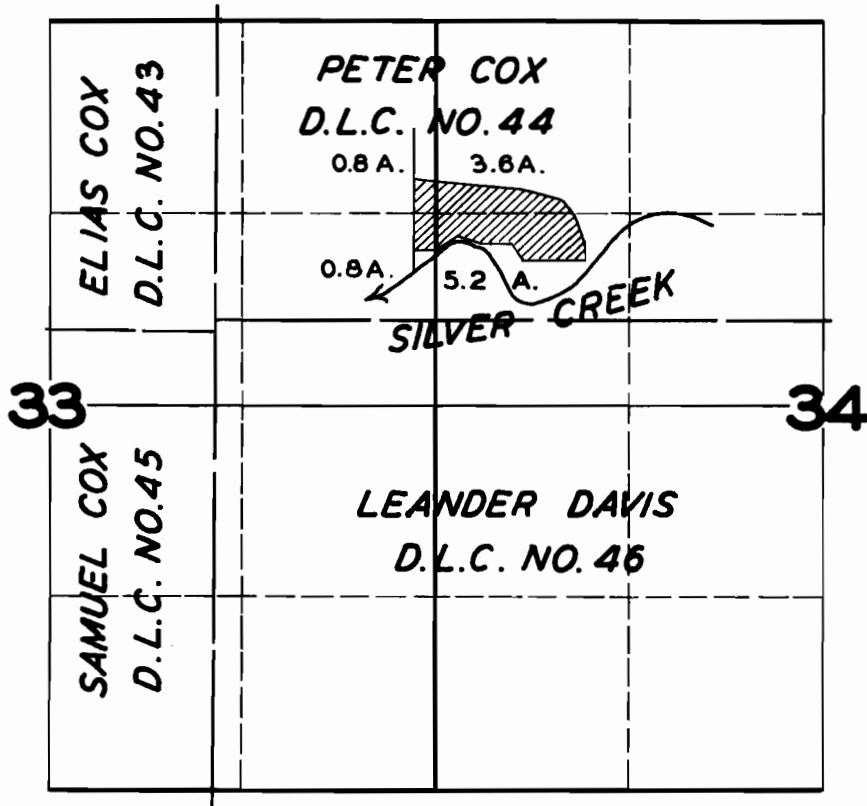

**FINAL PROOF SURVEY**  
UNDER

Application No. **19314** Permit No. **14897**  
IN NAME OF

**D.L. & HATTIE COLL**

Surveyed **MAR. 23 1948**, by **JAS. E. BUNNELL**