


# T.17S.R.4W.W.M.

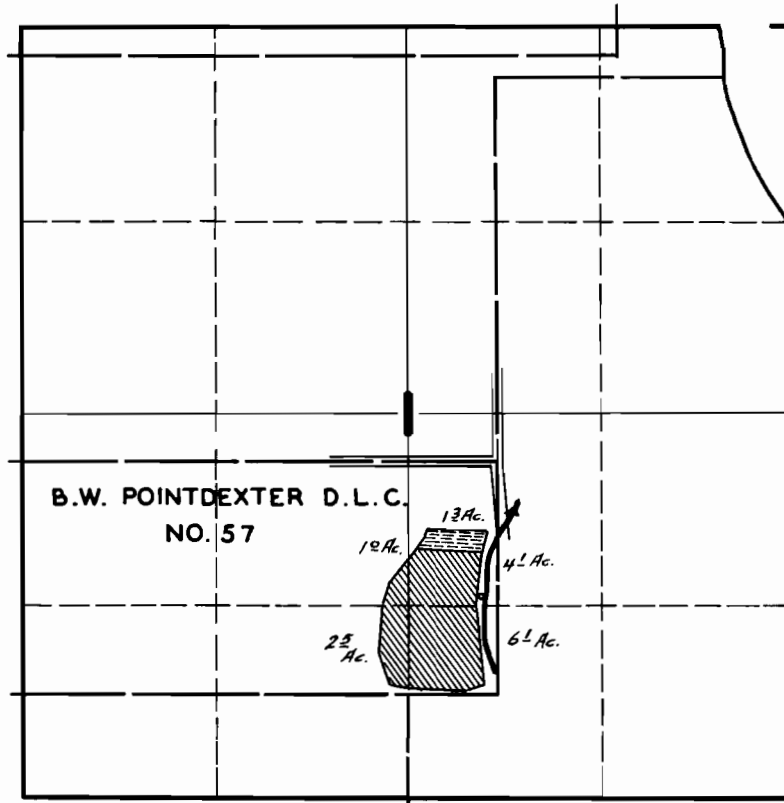

## FINAL PROOF SURVEY UNDER

Application No. 19740 Permit No. 15327

IN NAME OF

W. J. LICHTY

Surveyed AUG. 8, 1947, by JAS. E. BUNNELL