


T. 6S. R. 6W. W.M.

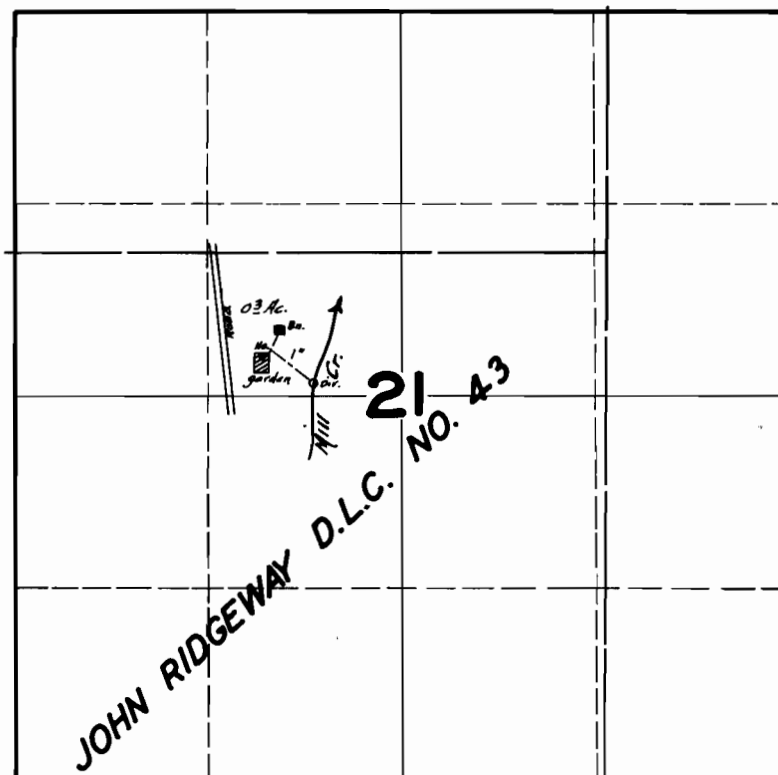

FINAL PROOF SURVEY UNDER

Application No. 19959 Permit No. 15530

IN NAME OF

LIZZIE L. EVANS

Surveyed JUNE 8 1945

A handwritten signature in cursive script, which appears to read "Paul B. Russell". The signature is written over the printed name "LIZZIE L. EVANS" and extends across the "Surveyed" line.