


T.2S.R.44E.WM

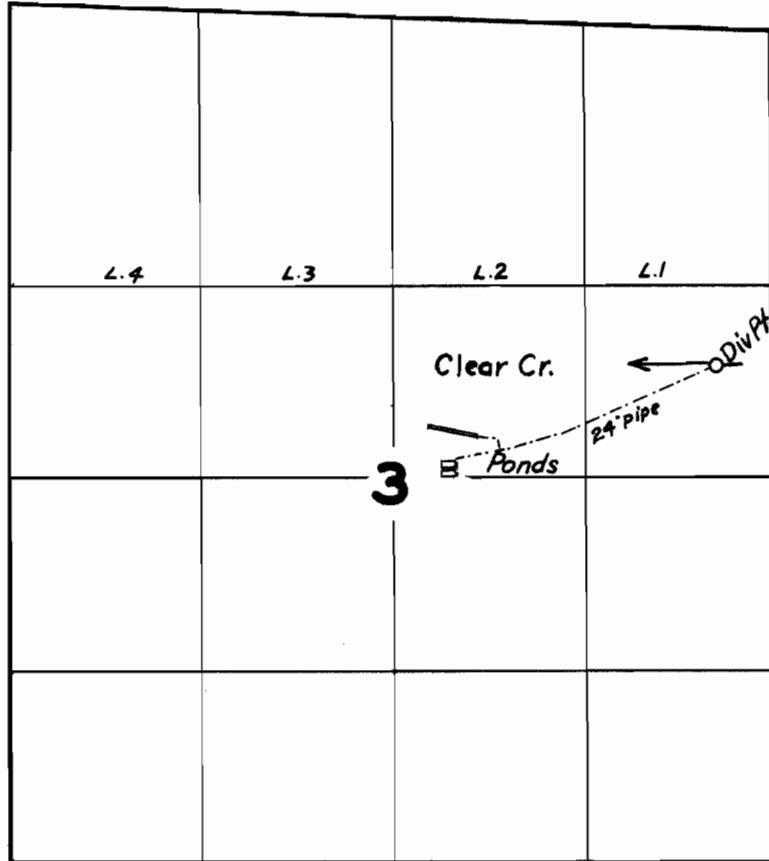

FINAL PROOF SURVEY UNDER

Application No. 20886 Permit No. 18674
IN NAME OF

Oregon State Game Commission

Surveyed Oct 15 19 53, by T. Jones