


T.9S.R.3E.W.M.

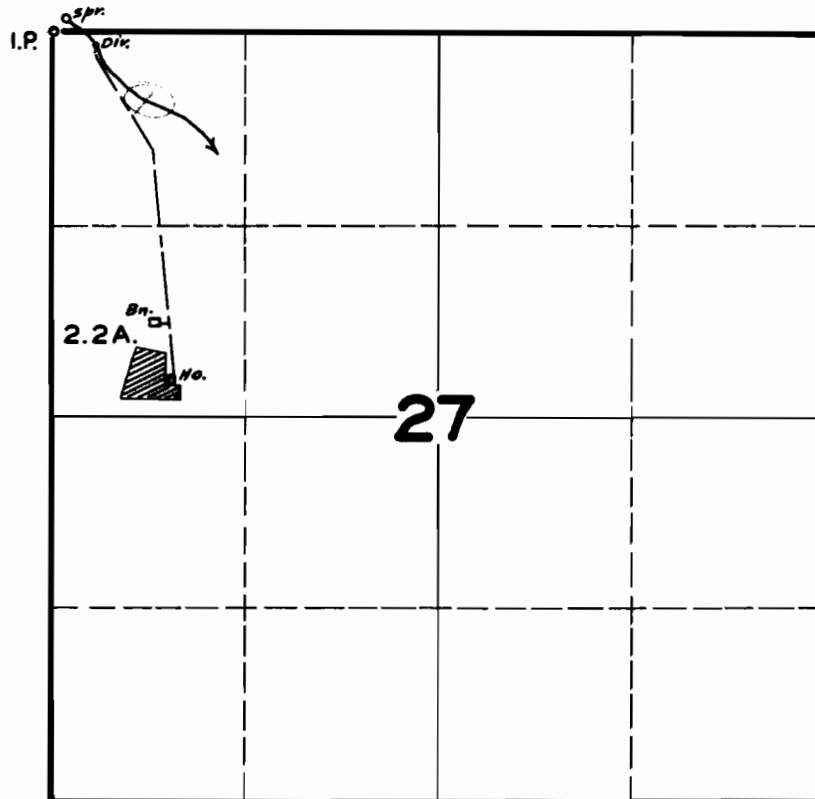

FINAL PROOF SURVEY
UNDER

Application No. **22126** Permit No. **17430**...
IN NAME OF

MRS. MARIE BOCK

Surveyed **APR. 19, 1948**, by **JAS. E. BUNNELL**