


T.14 S., R7&8 W., W.M.

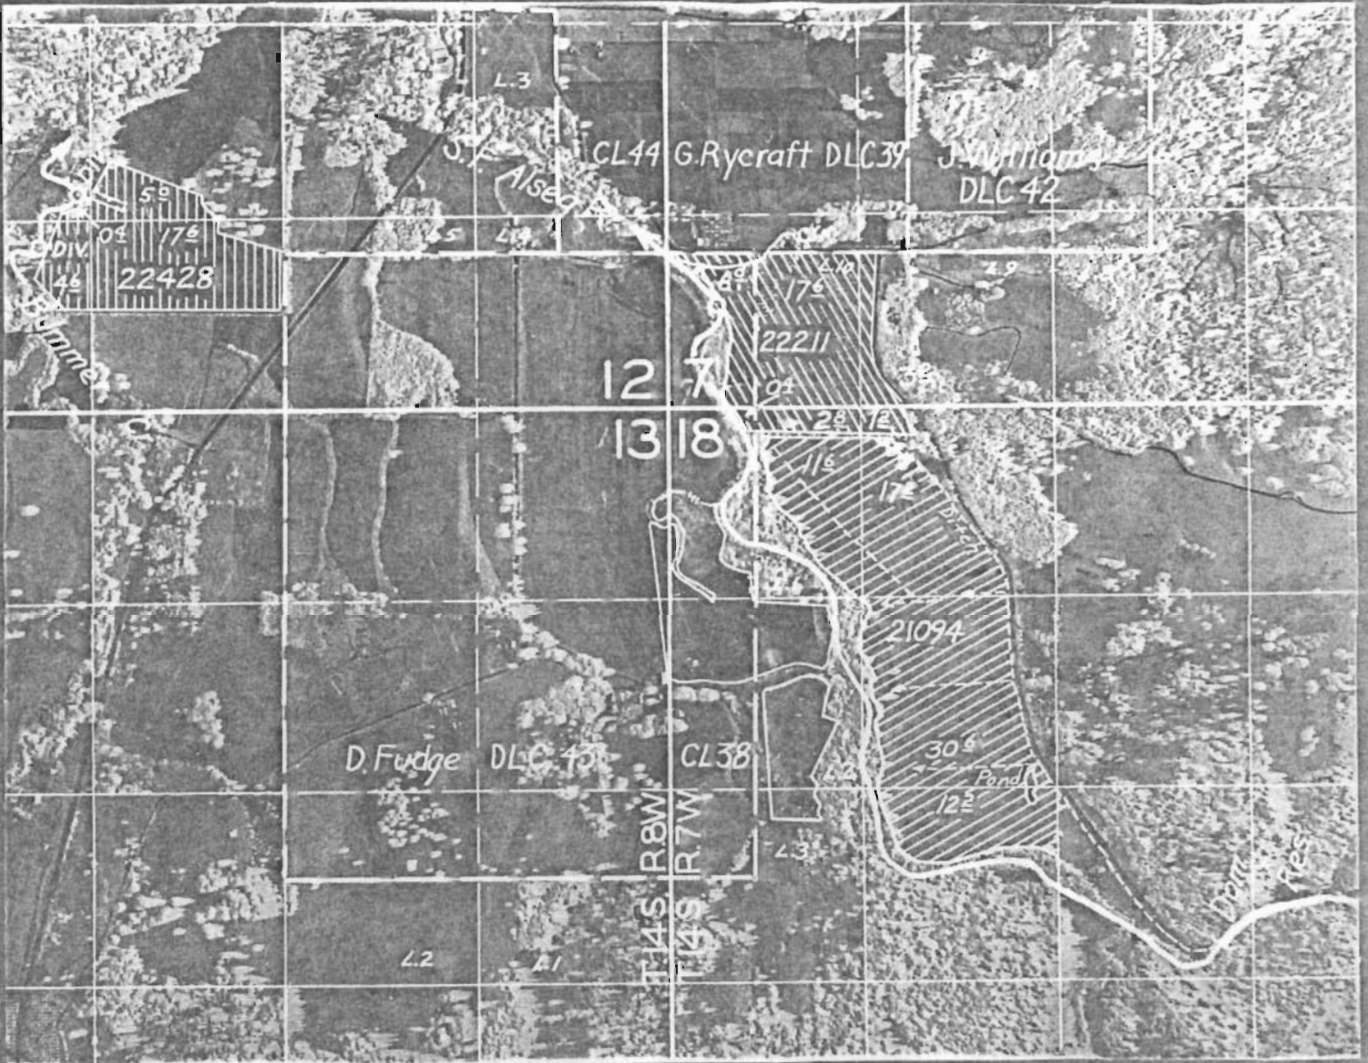

### FINAL PROOF SURVEY

UNDER

Application No. 21094      Permit No. 16531

IN NAME OF

Horace P. Swearingin..... A.W. Brown..... Harold E Hennings


Surveyed Sept, 9, 1953, by H.L. Coffman

DJ-10-112

SECTION

TOWNSHIP 14 S, RANGE 8 W, W. M.

North

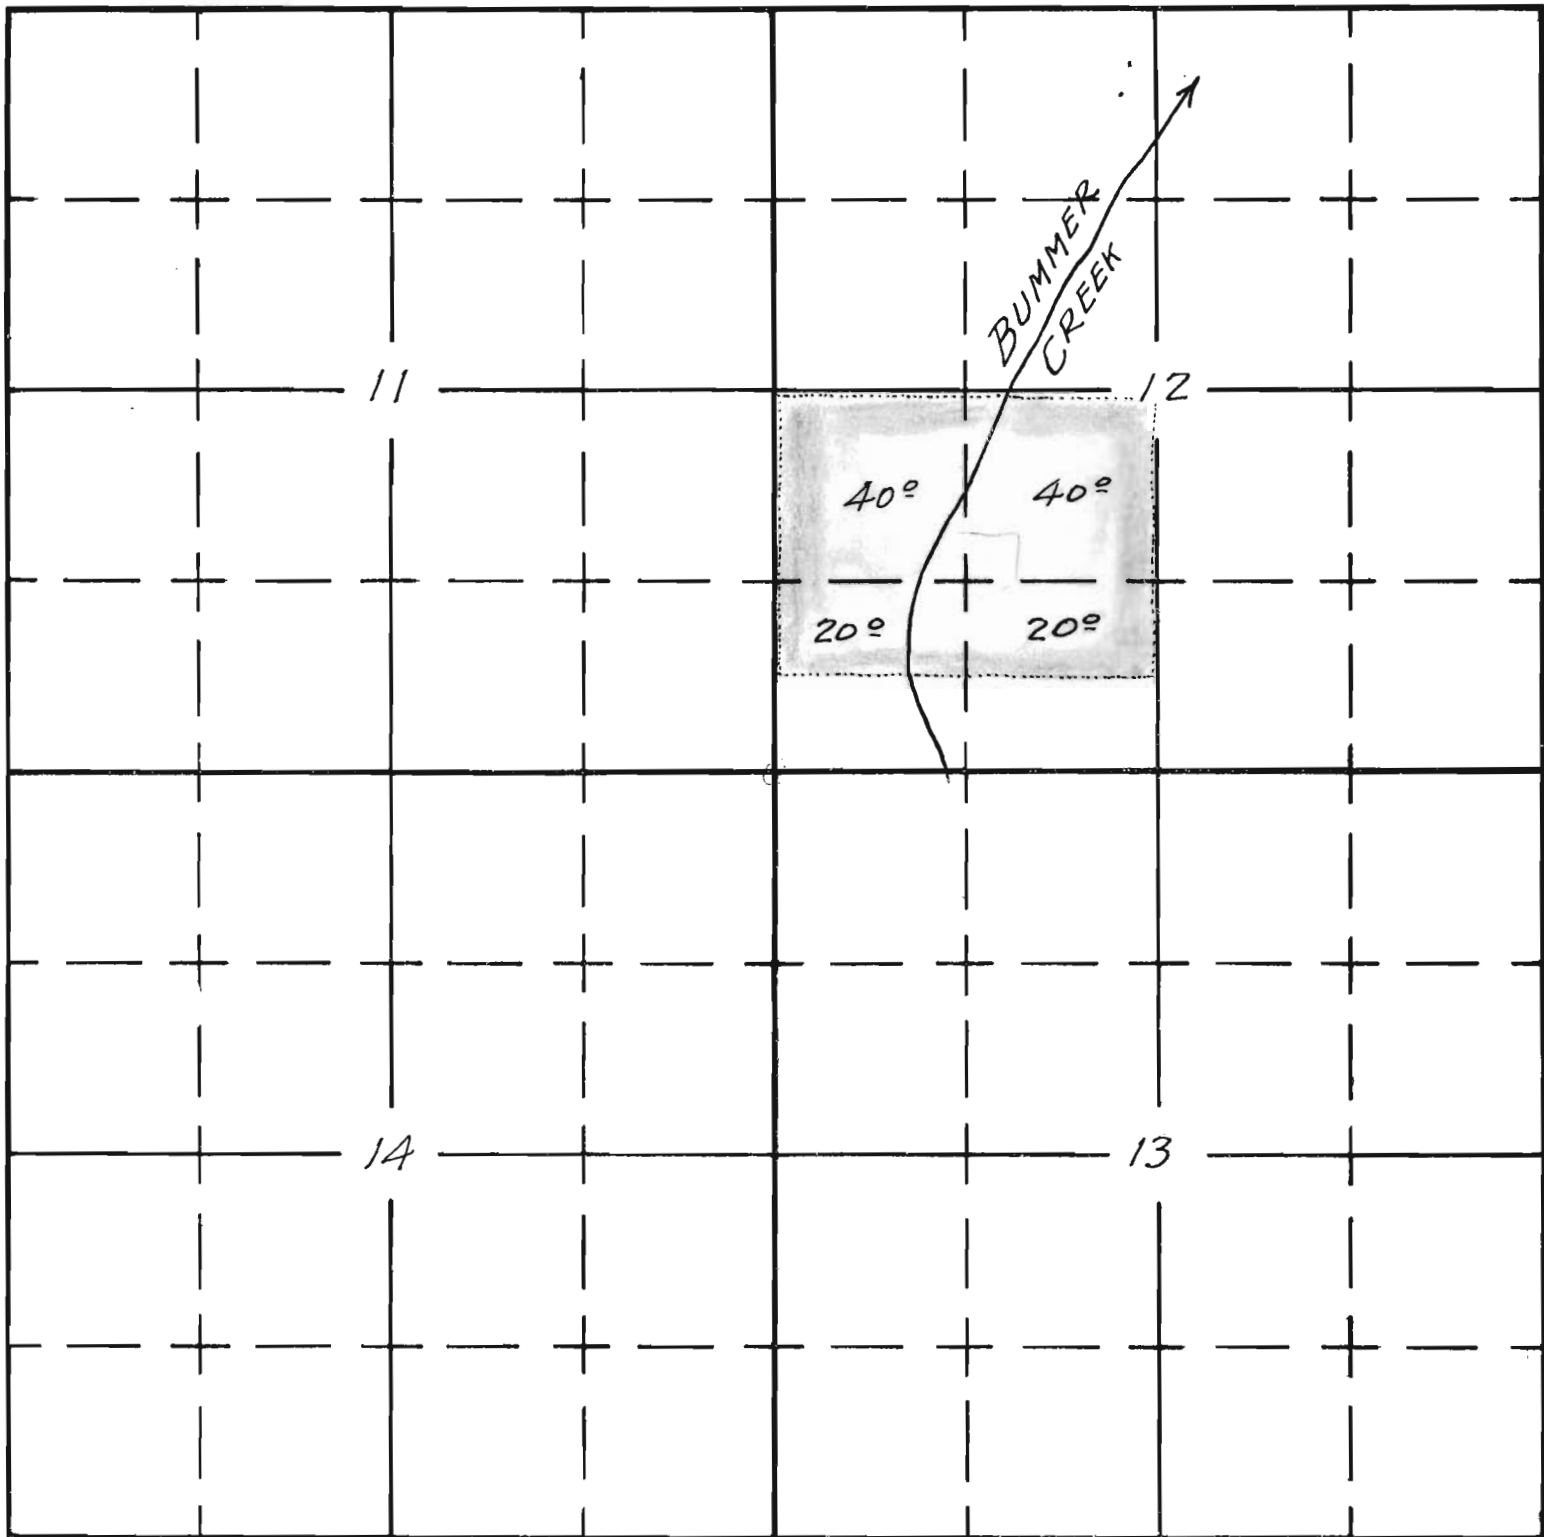

South

SKETCHED IN THE OFFICE  
OF THE STATE ENGINEER  
FROM DATA BY APPLICANT

A-8-47

*Signature*

APPLICATION No. 22428  
PERMIT No. 17673