


T.6 S.R. I.W.W.M.

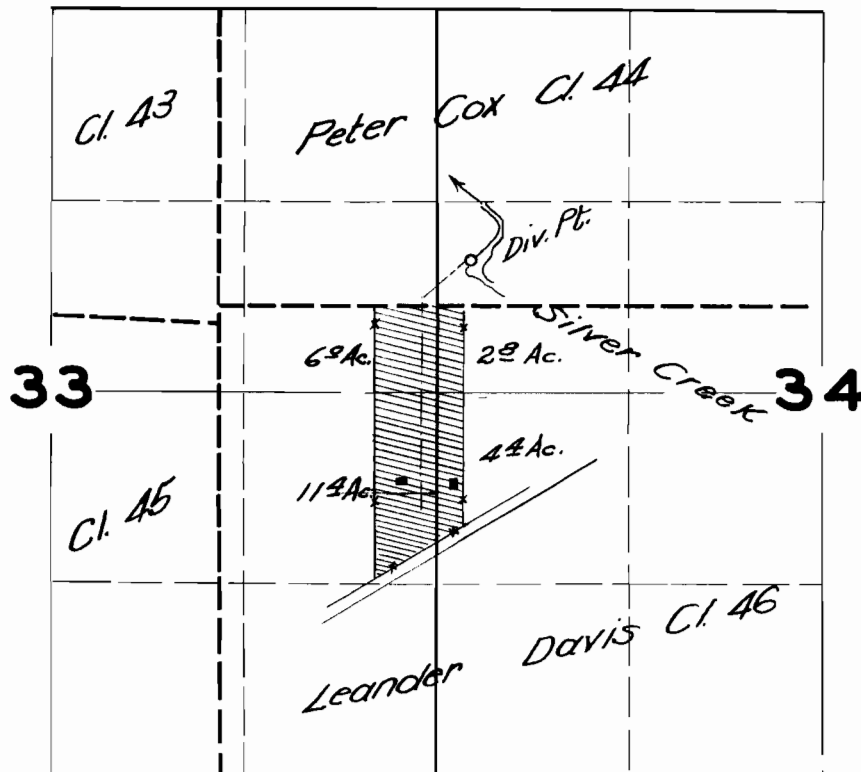

FINAL PROOF SURVEY

UNDER

Application No. 21418 ... Permit No. 16780...

IN NAME OF

R. M. COOLEY

Surveyed AUG 28 1950, by H.L. COFFMAN