


TOWNSHIP 41S, RANGE 12W, W. M.

North

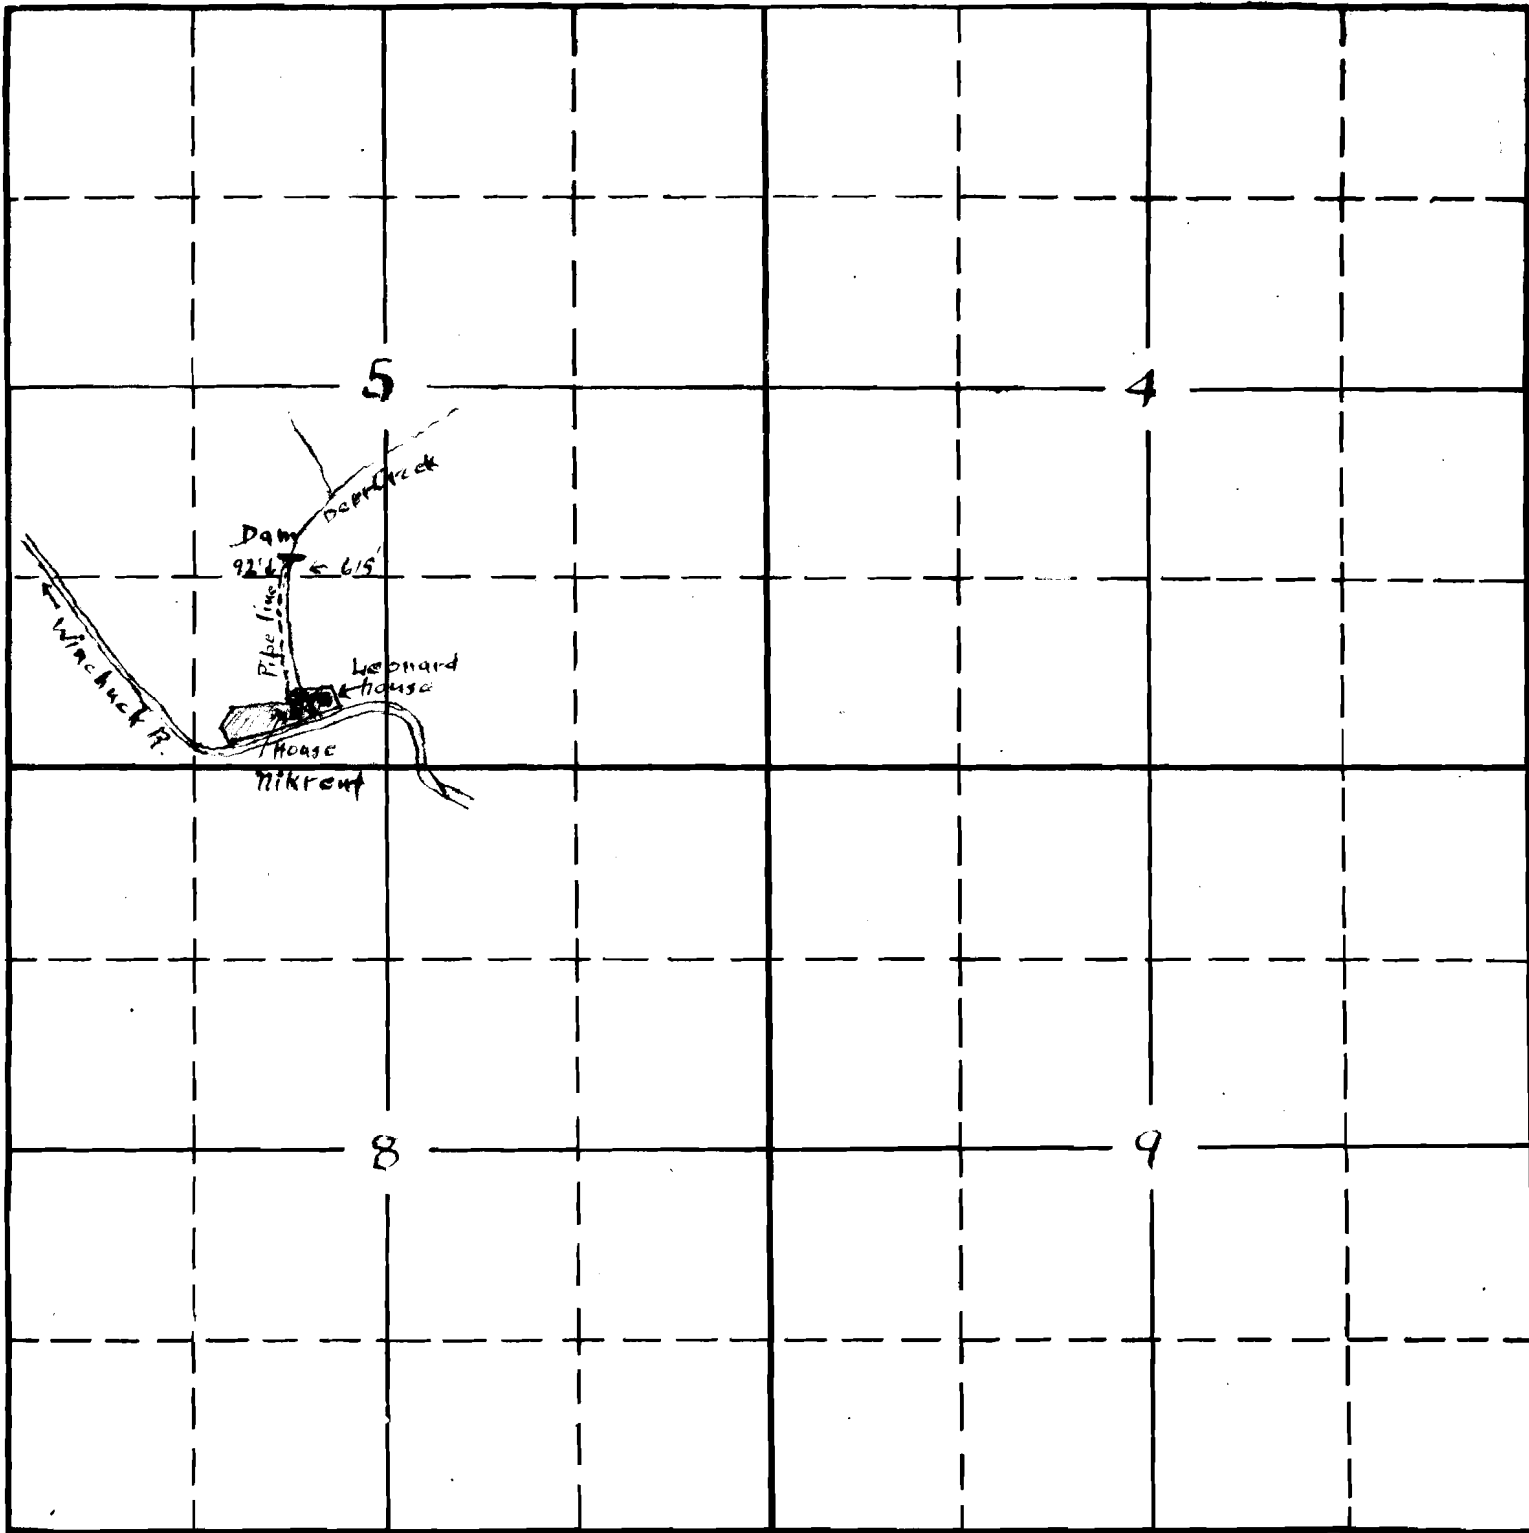

South

22186

15-20

APPLICATION No. 22186

PERMIT No. 17471

RECEIVED  
 DEPARTMENT OF  
 AGRICULTURE  
 OREGON