


T.7S.R.IW.W.M.

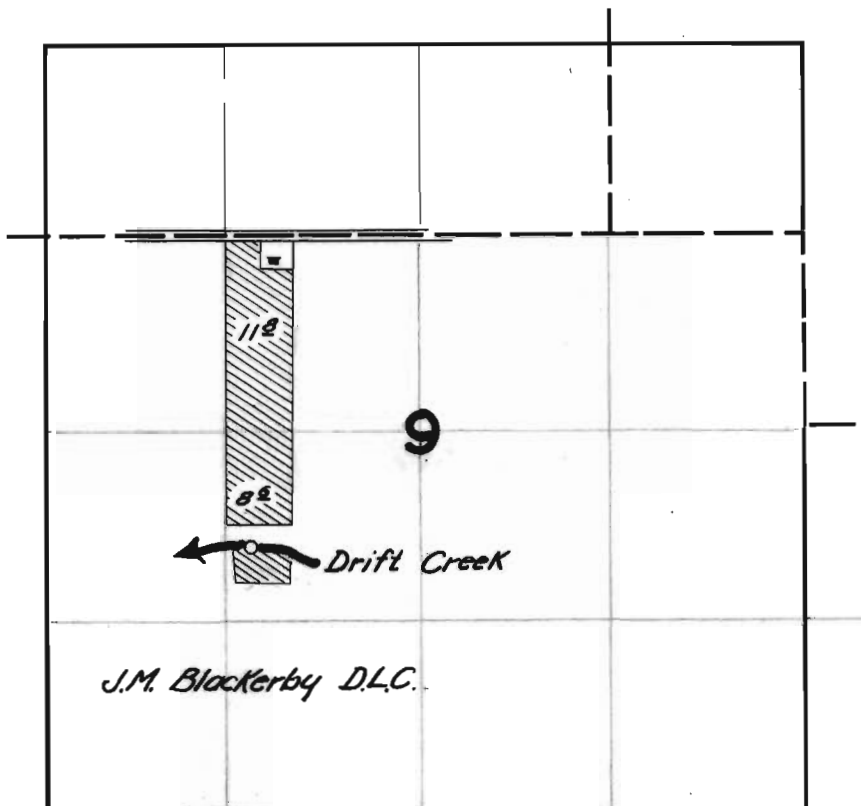

FINAL PROOF SURVEY
UNDER

Application No. 22389 Permit No. 17702
IN NAME OF
FRED ZURBRUGG

Surveyed Aug. 15 1952, by H. L. Coffman