


T. . . . ., R. . . . ., W.M.

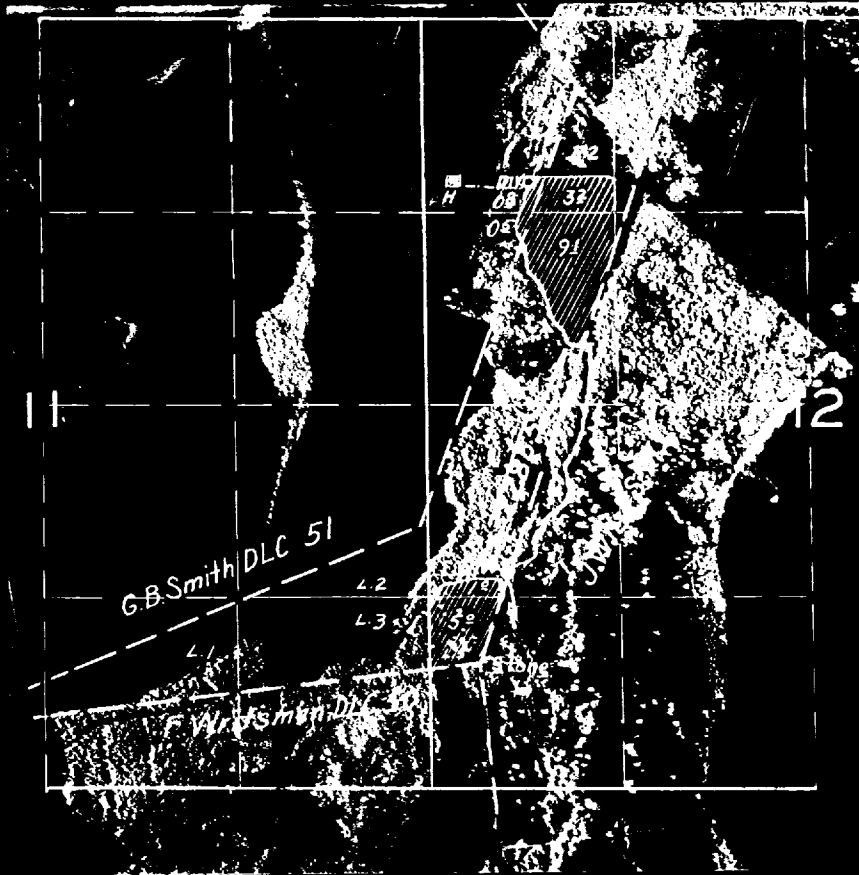

# FINAL PROOF SURVEY

UNDER

Application No. . . . . Permit No. . . . .  
IN NAME OF

Surveyed . . . . . 19 . . . . . by . . . . .