

15


14

T.41S.R.13W.W.M.

22

23

24

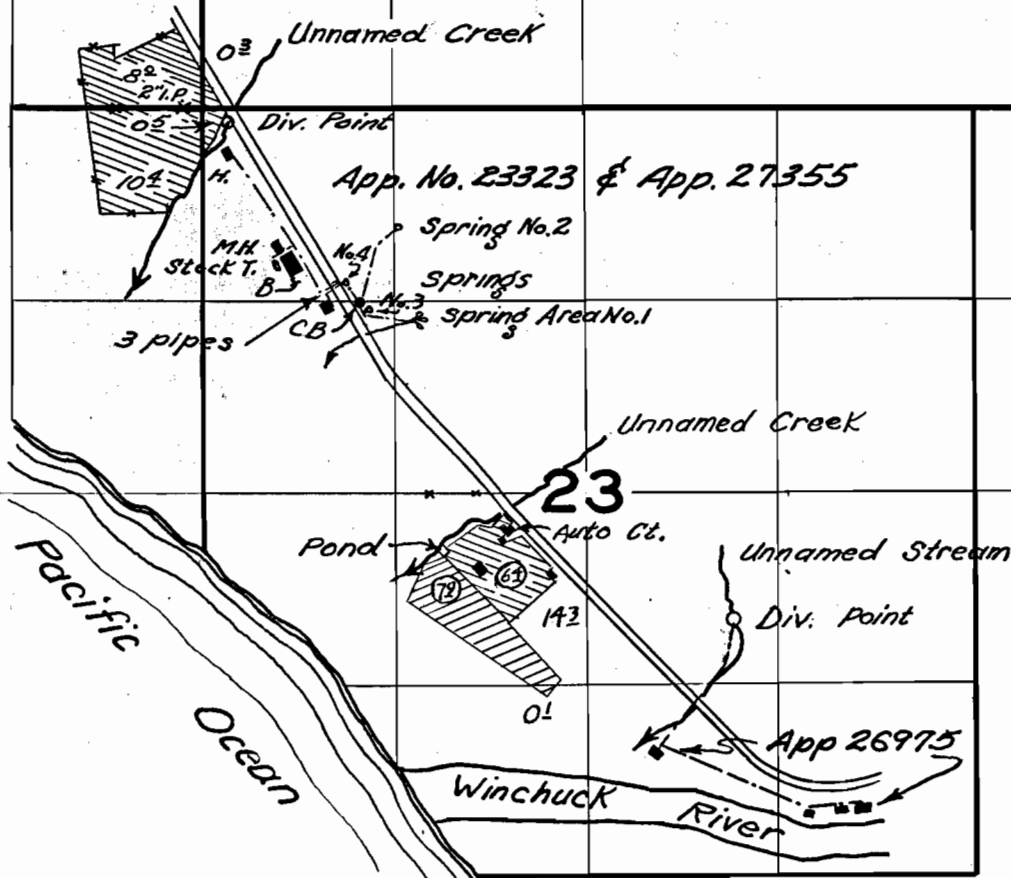

### FINAL PROOF SURVEY

27355 UNDER 21537

23323 18560

20008 15579

Application No. 26975 Permit No. 21408

IN NAME OF

Donald T. Crockett David E. and Ardis S. DeArmond  
Martha D. and Floyd McAdams and Walter Biddle. and

Enos A Potts

Surveyed Sept. 17, 1953, by H.L. Coffman

Aug 11 1949

1953-D

File in 26975