


T.12 S. R.1 W. W. M.

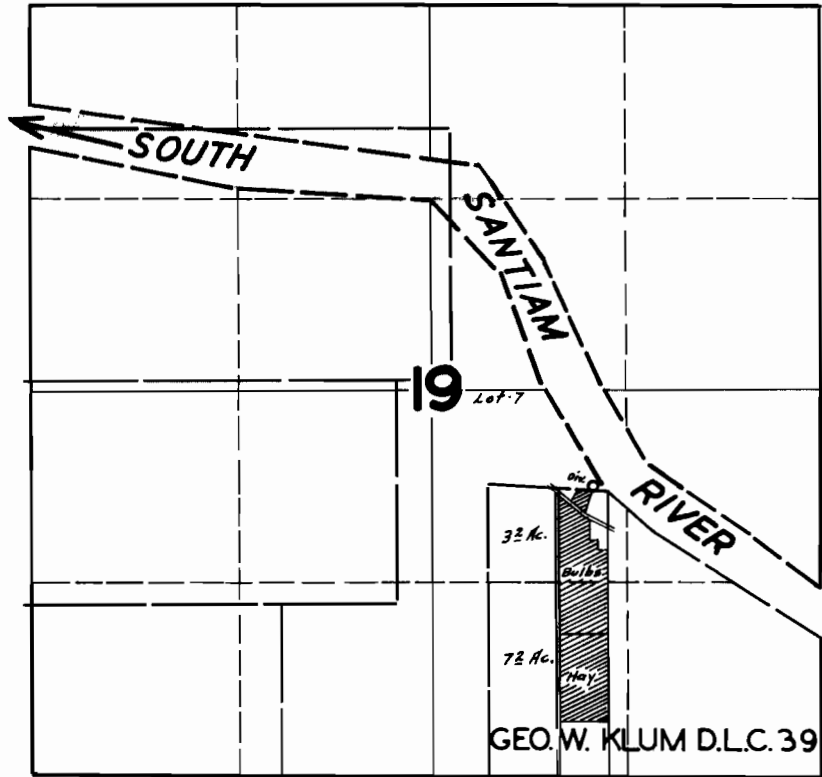

FINAL PROOF SURVEY UNDER

Application No. 18192 Permit No. 13819

IN NAME OF

GRANT E. MITSCH

Surveyed JUNE 30 1945, by