


T.8S.R.IE.W.M.

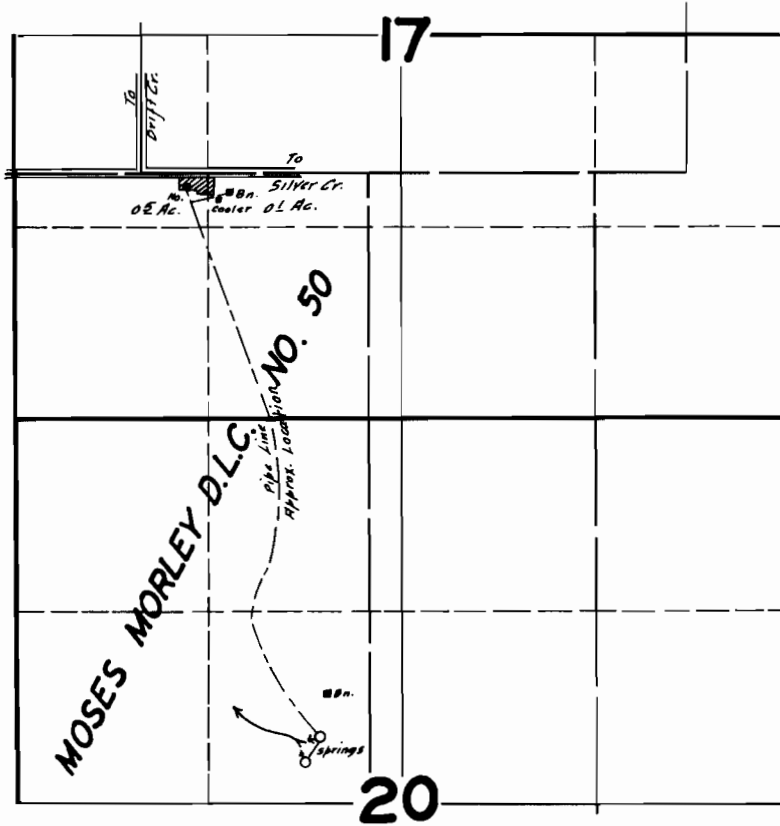

FINAL PROOF SURVEY UNDER

Application No. 18678 Permit No. 14309

IN NAME OF

B. E. BOWER.

Surveyed MAY 22, 1948, by *[Signature]*