


T. 11 S. R. 4 W. W. M.

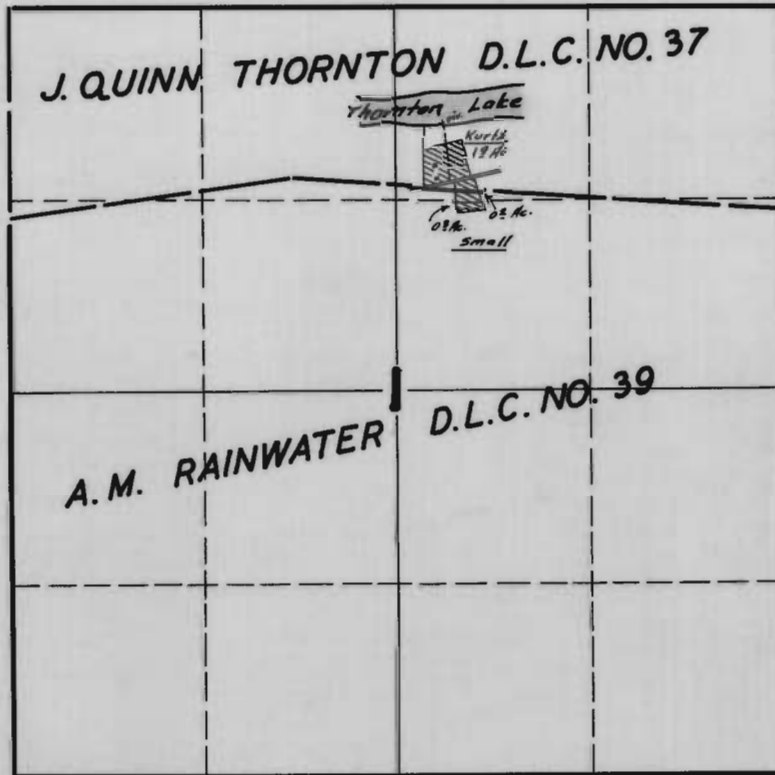

FINAL PROOF SURVEY

UNDER

Application No. 18689 Permit No. 14316

IN NAME OF

WREN SMALL & WM. H. KURTZ

Surveyed MAY 11 1946 by

[Handwritten Signature]