


T.4S. R.2 & 3 W.W.M.

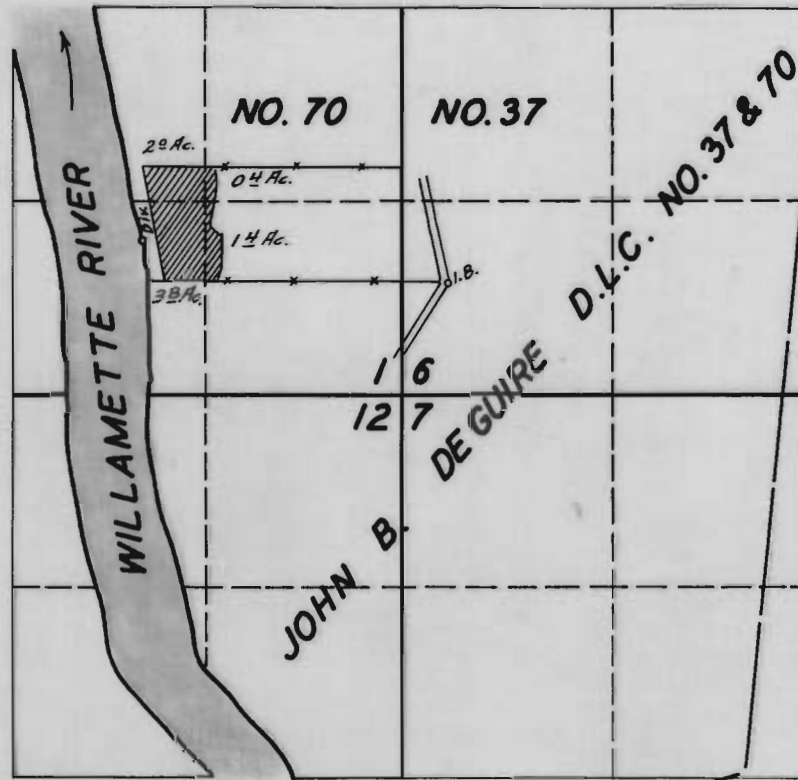

FINAL PROOF SURVEY UNDER

Application No. 19213 Permit No. 14805

IN NAME OF

A. F. JUNGWIRTH

Surveyed JUN. 19 1947, by JAS. E. BUNNELL