


T.6S. R.1W. W.M.

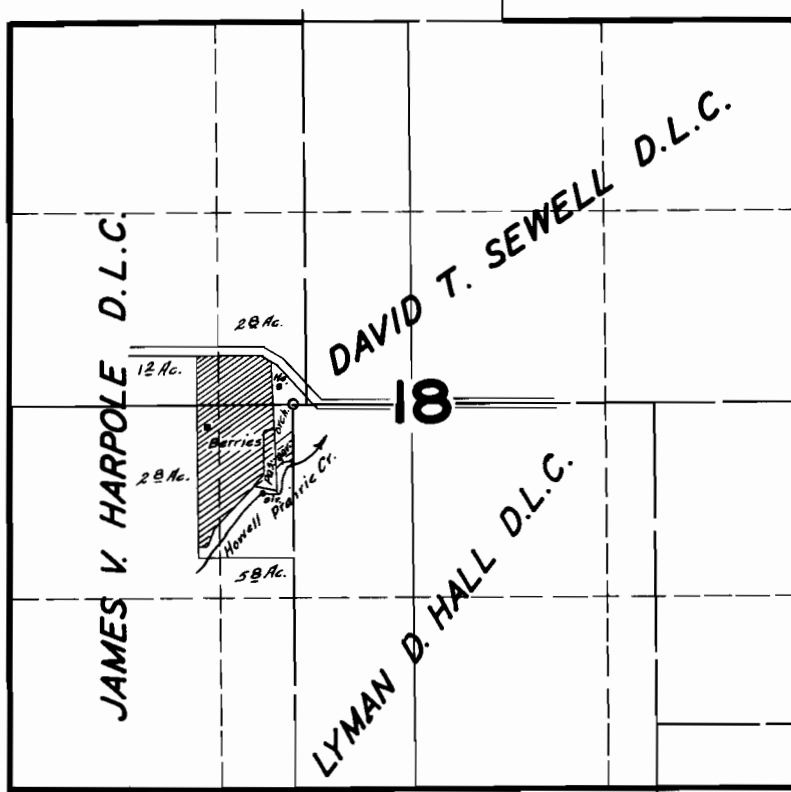

FINAL PROOF SURVEY

UNDER

Application No. 19996 Permit No. 15574

IN NAME OF

PEARL PICKENS

Surveyed SEPT. 5, 1945, by