


T.I.S.R.I.E.W.M.

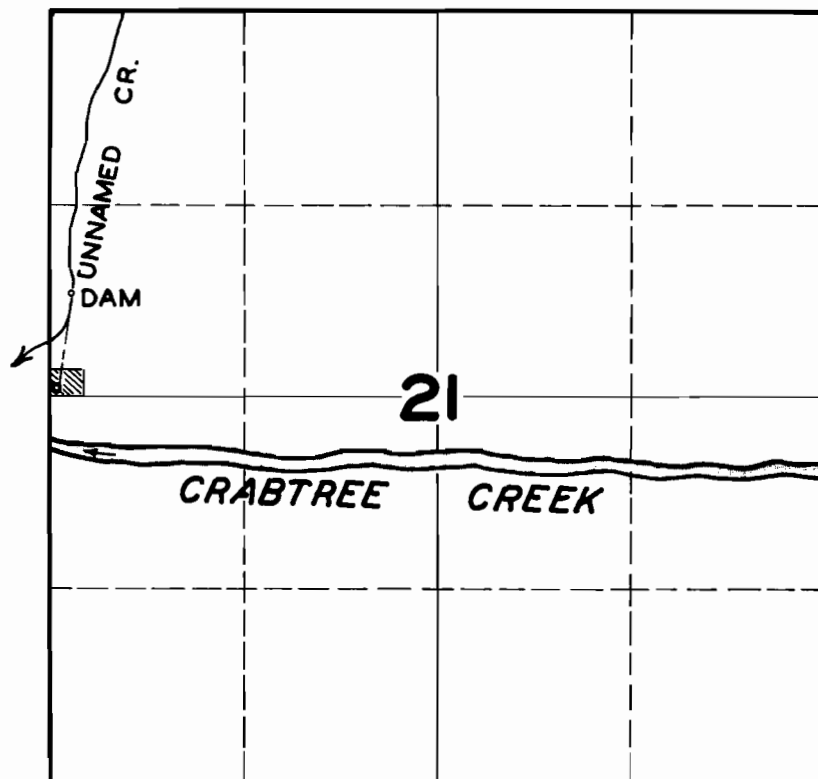

FINAL PROOF SURVEY UNDER

Application No. **20702** Permit No. **16190**
IN NAME OF

HAROLD F. LANDER

Surveyed **MAR. 31, 1949**, by **JAS. E. BUNNELL**