


# T.41 S.R.13 W.W.M.

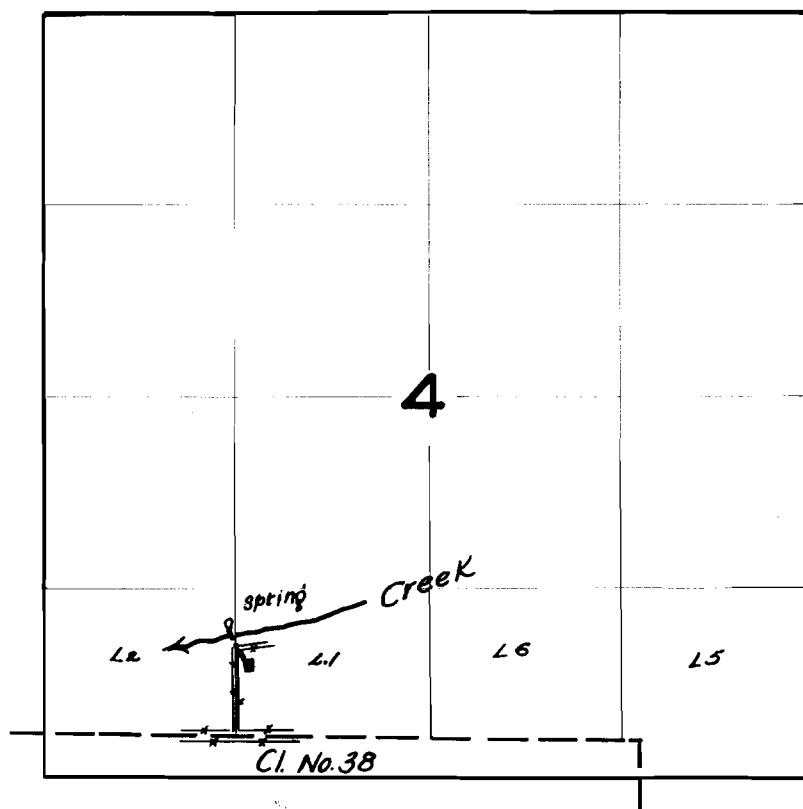

## FINAL PROOF SURVEY

UNDER

Application No. 21497 Permit No. 16860

IN NAME OF

Fred A. and Verna F. Anderson

Surveyed Sept 22 19 53, by H.L. Coffman

1953-D