


T. I. S. R. 38 & 39 E. W. M.

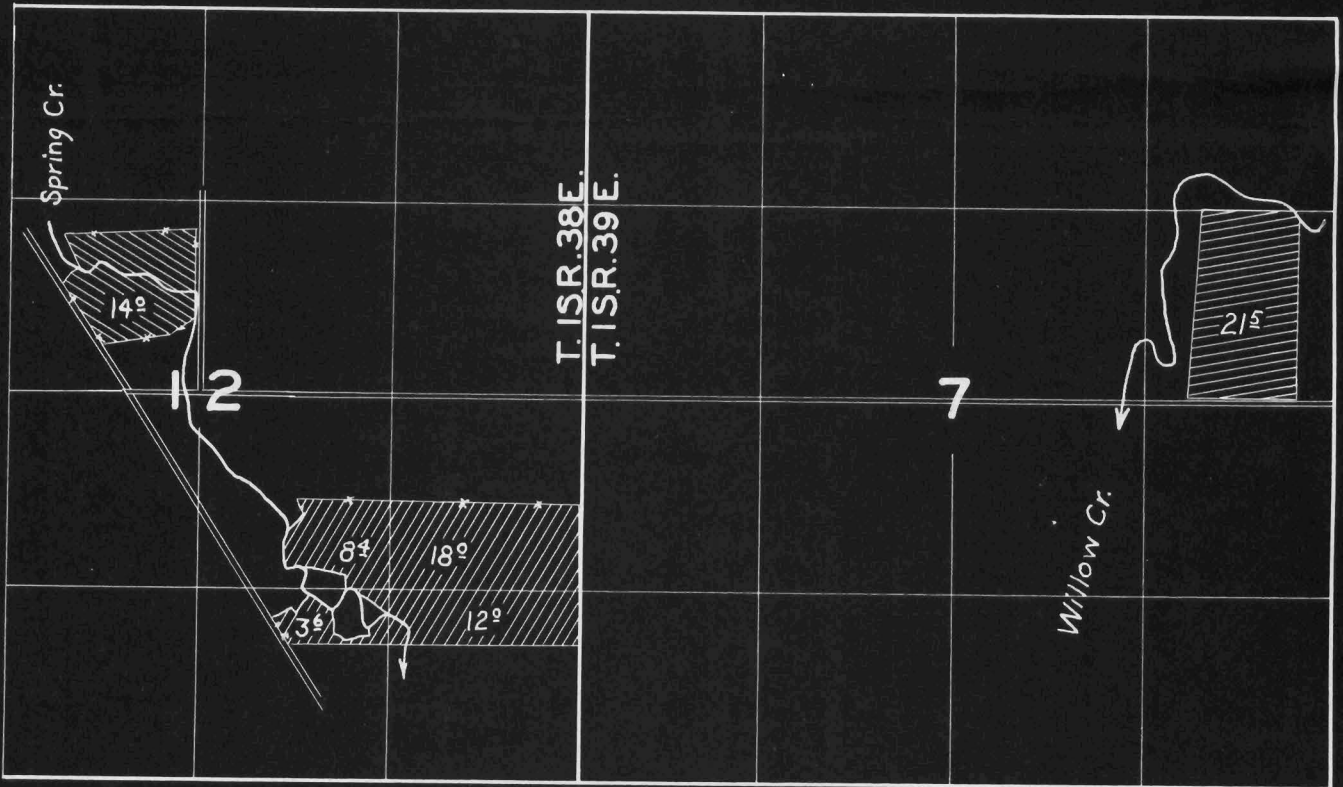

Appl No 22400..... 
 Appl No 22402..... 
 Appl No. 22401..... 

FINAL PROOF SURVEY

UNDER
 22400 17657
 22401 17658
 Application No. 22402 Permit No. 17659

IN NAME OF
 Hugh Park and Wayne Park
 Leroy McKenzie

Surveyed Oct 8, 9 1953, by T. Jones