


T. I. S. R. 38 & 39 E. W M

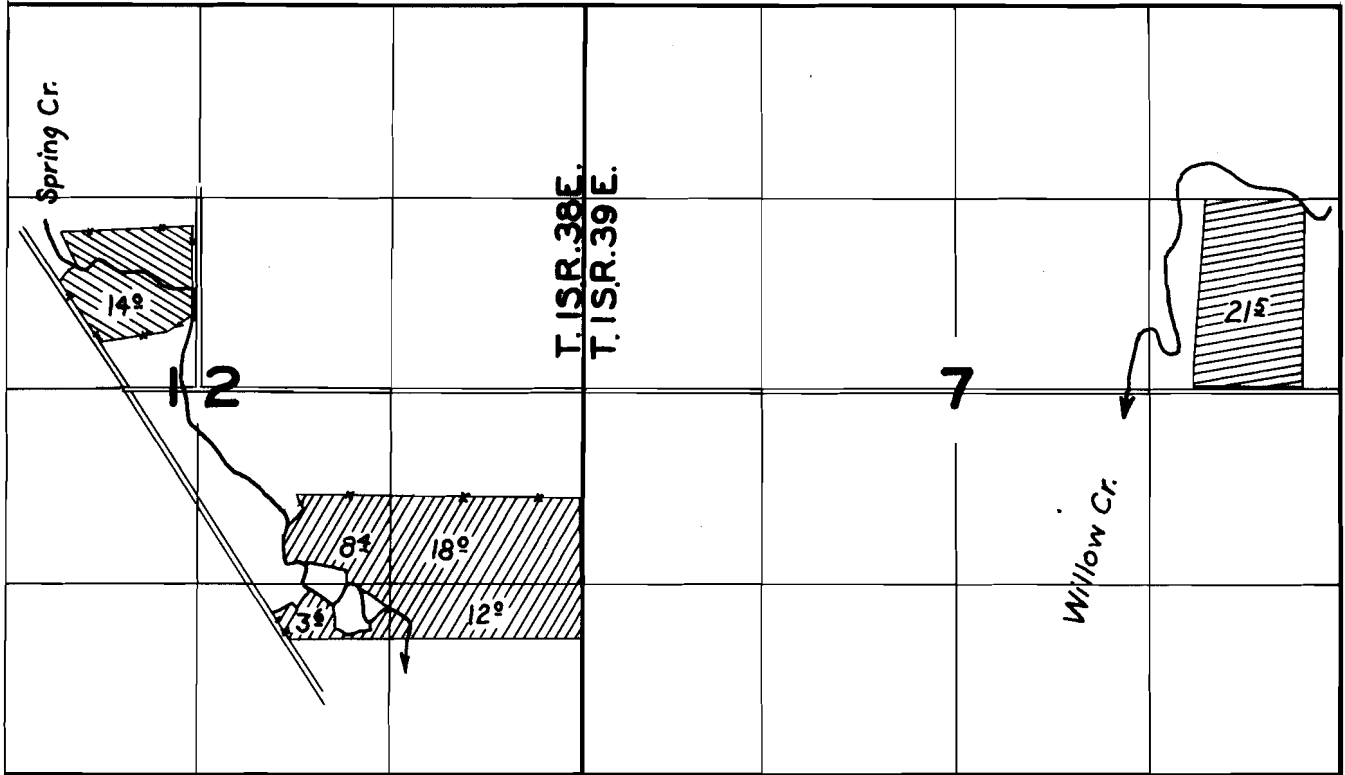

- Appl No 22400.....
- Appl No 22402.....
- Appl No. 22401.....

FINAL PROOF SURVEY

UNDER
 22400 17657
 22401 17658
 Application No. 22402..... Permit No. 17659
 IN NAME OF
 Hugh Park and Wayne Park
 LeRoy McKenzie

Surveyed Oct 8, 9 1953, by T. Jones