


T.29 S. R.5 W.W.M.

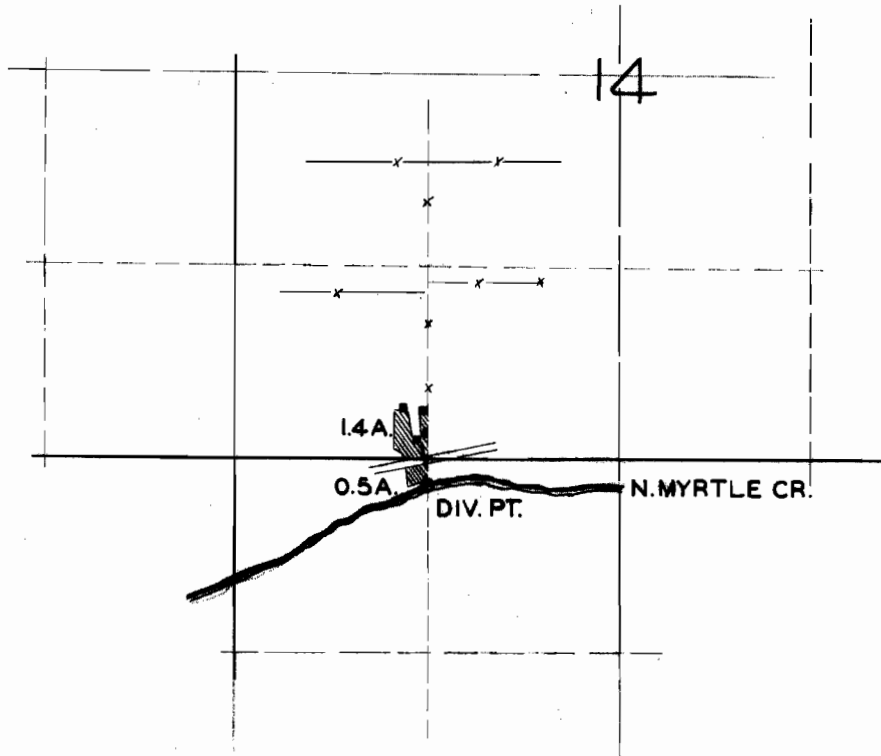

FINAL PROOF SURVEY UNDER

Application No. 22498. Permit No. 17735
IN NAME OF

C.S. RENHARD

Surveyed JUL. 22 1949, by H.L. COFFMAN