


T.5S. R.2E. W.M.

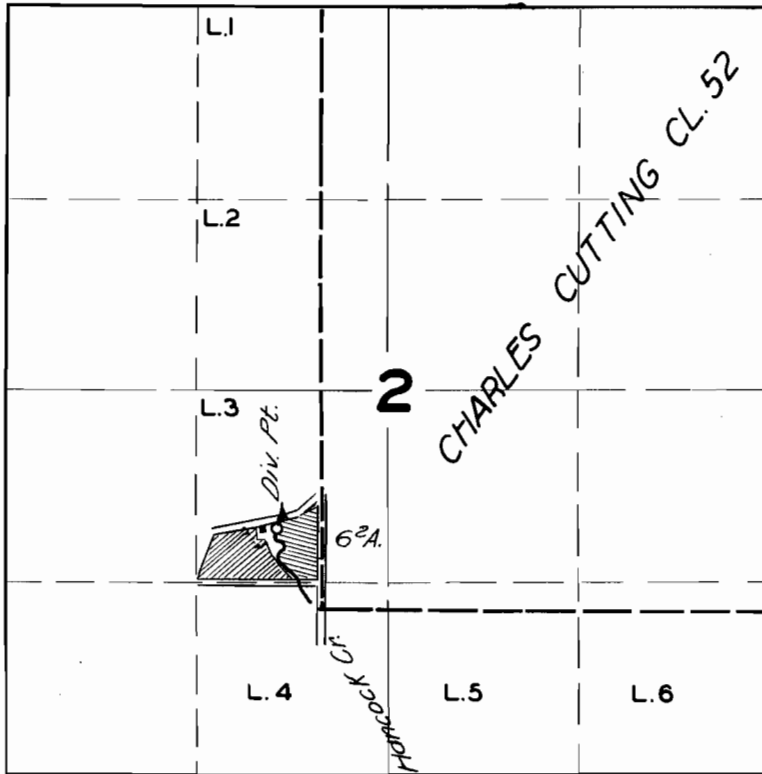

FINAL PROOF SURVEY UNDER

Application No. **23113**... Permit No. **18219**...
IN NAME OF

.....**B.W. BATTLESON**.....

Surveyed APR. 18, 1950., by H.L. COFFMAN