


T. 4 S., R. 1 W., W.M.

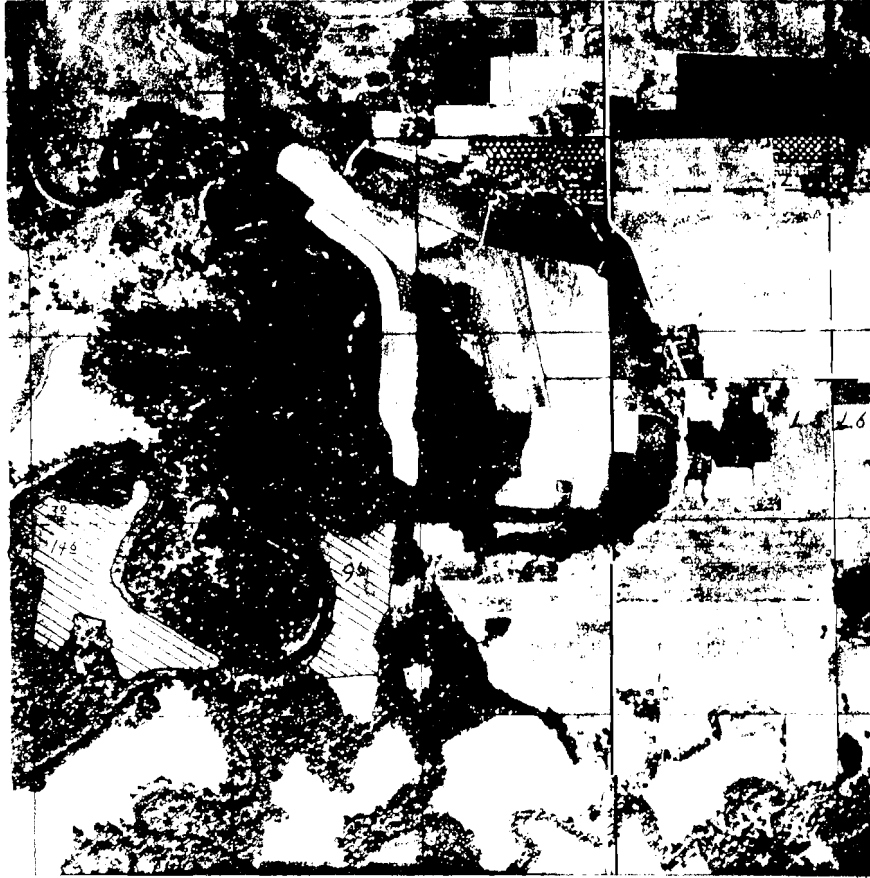

## FINAL PROOF SURVEY

UNDER

Application No. 23525 Permit No. 17910  
IN NAME OF

DONALD L. OLSON

Surveyed July 10 1953, by H. L. Coffman

DFK-3D-20