


# T. 30S., R. 5 W., W.M. SECTION 33

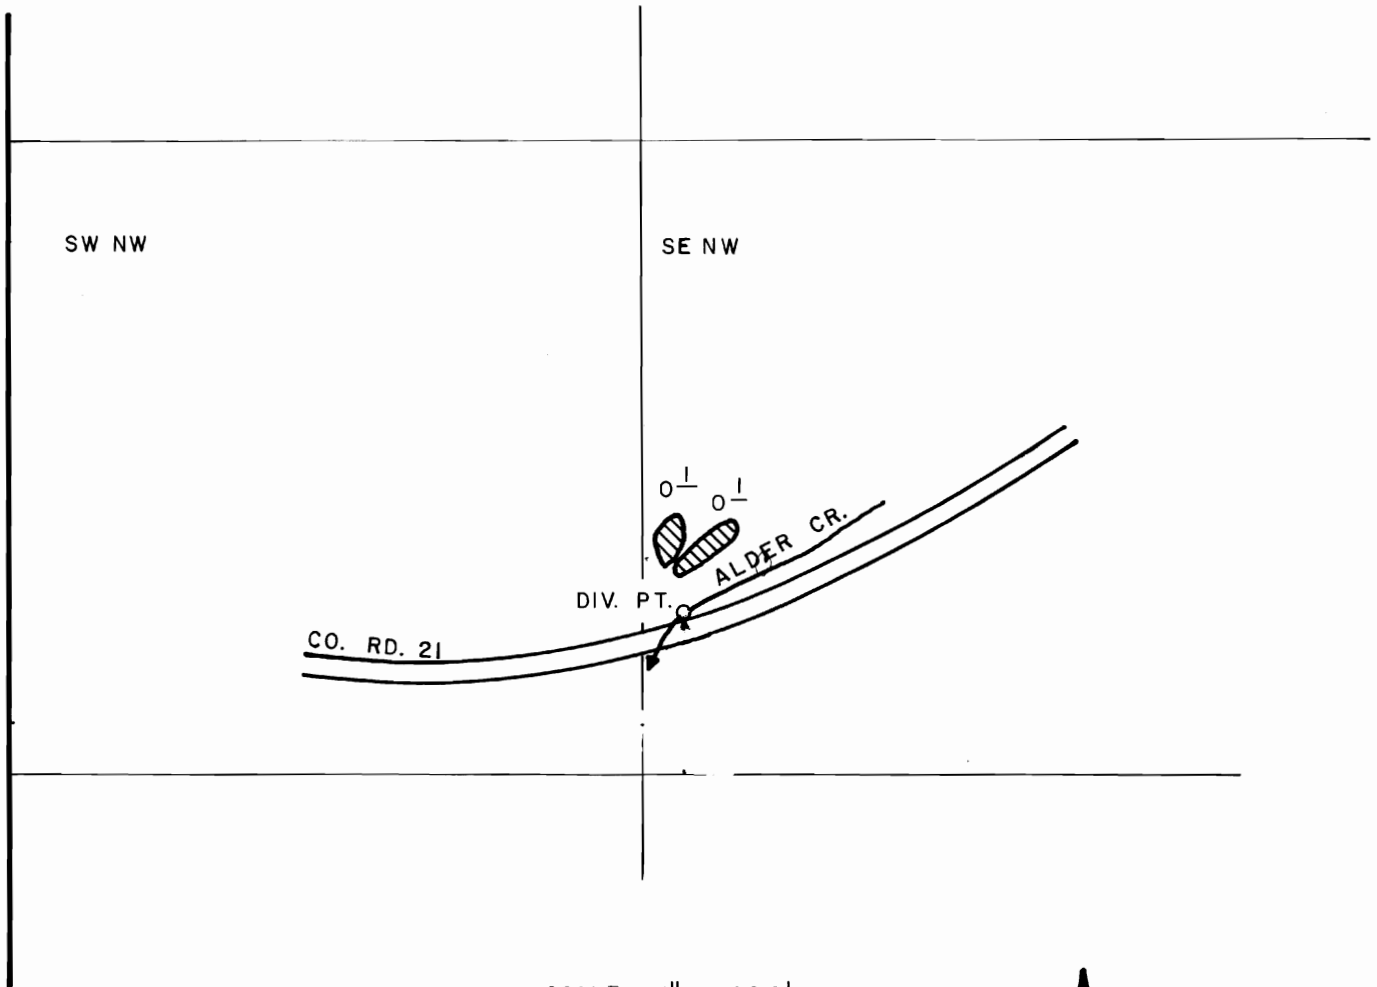

SCALE: 1" = 400'



## FINAL PROOF SURVEY UNDER

TRANSFE NO. 5521 OLD CERTIFICATE NO. 20500  
IN NAME OF

**ROBERT E. PROCTOR**

Surveyed MAY 29, 1986, by J. M. SCHMORDE

8/11/06

JWS