


T. 4 S., R. 1 E., W.M.

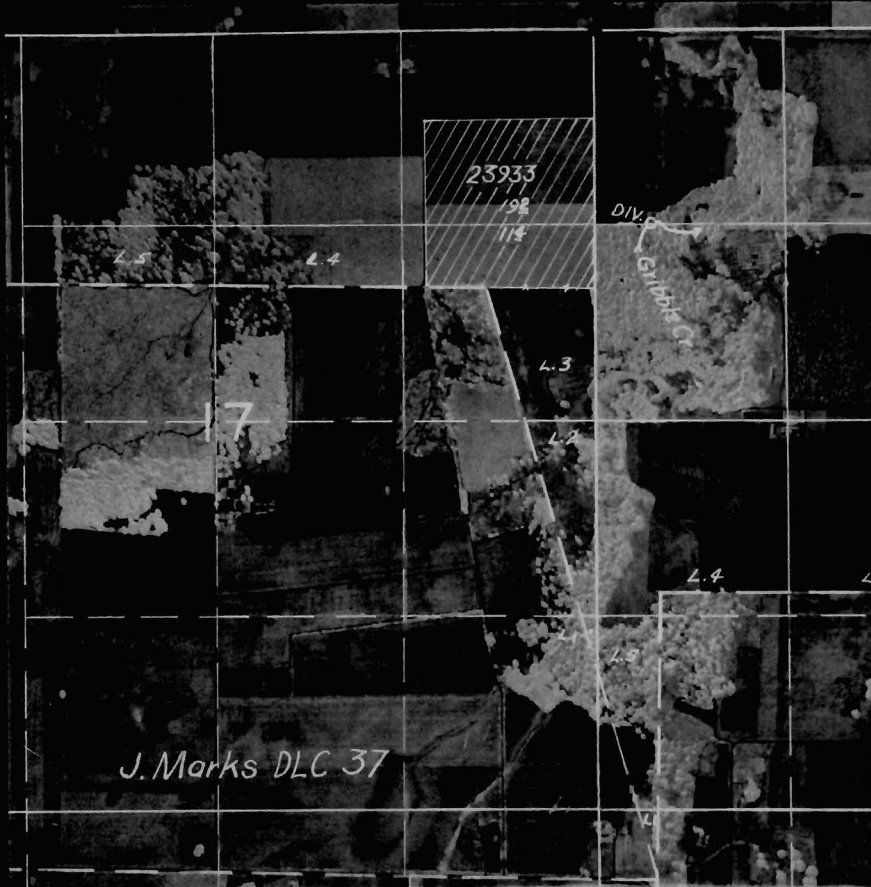

FINAL PROOF SURVEY

UNDER

Application No. 23933 Permit No. 18847

IN NAME OF

H. W. PETER

Surveyed April 30 1953, by H. L. Coffman

DFK-3D-49