


T.36 S. R. 14 W. W. M.

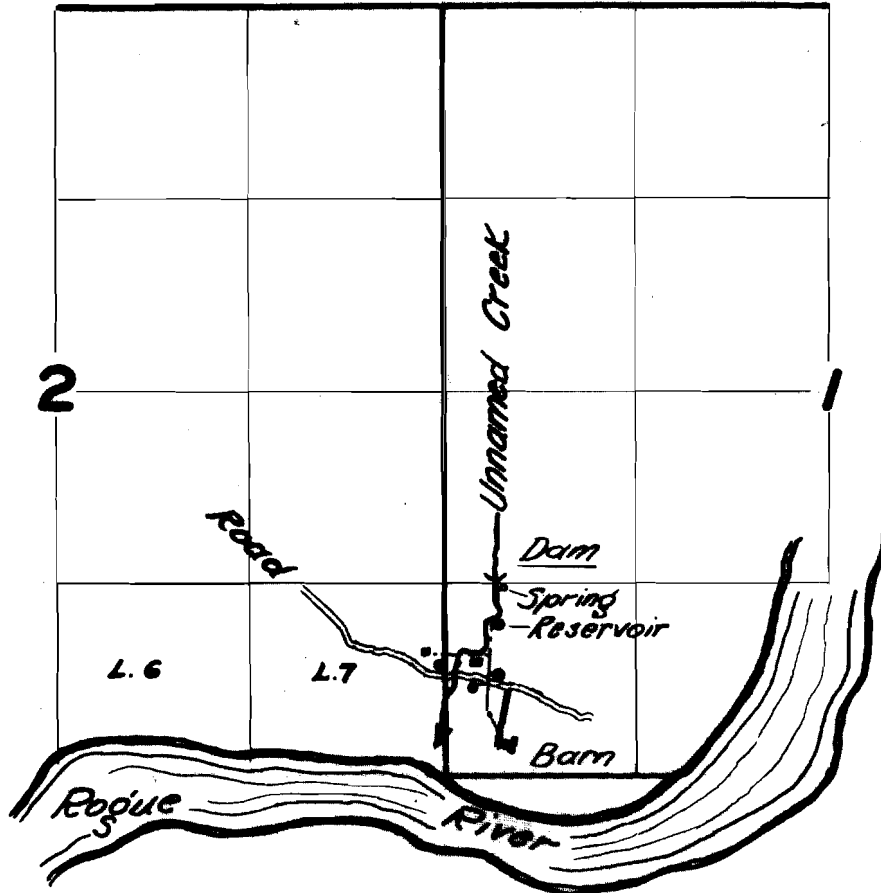

Stock trough •  
House ■  
**FINAL PROOF SURVEY**  
UNDER

Application No. 23853..... Permit No. 18788.....  
IN NAME OF

L.W. Watson and Anna M. Watson.....

Surveyed Sept. 15, 1953, by H.L. Coffman.....

Sep