


T. 4 | S. R. 13 W. W. M.

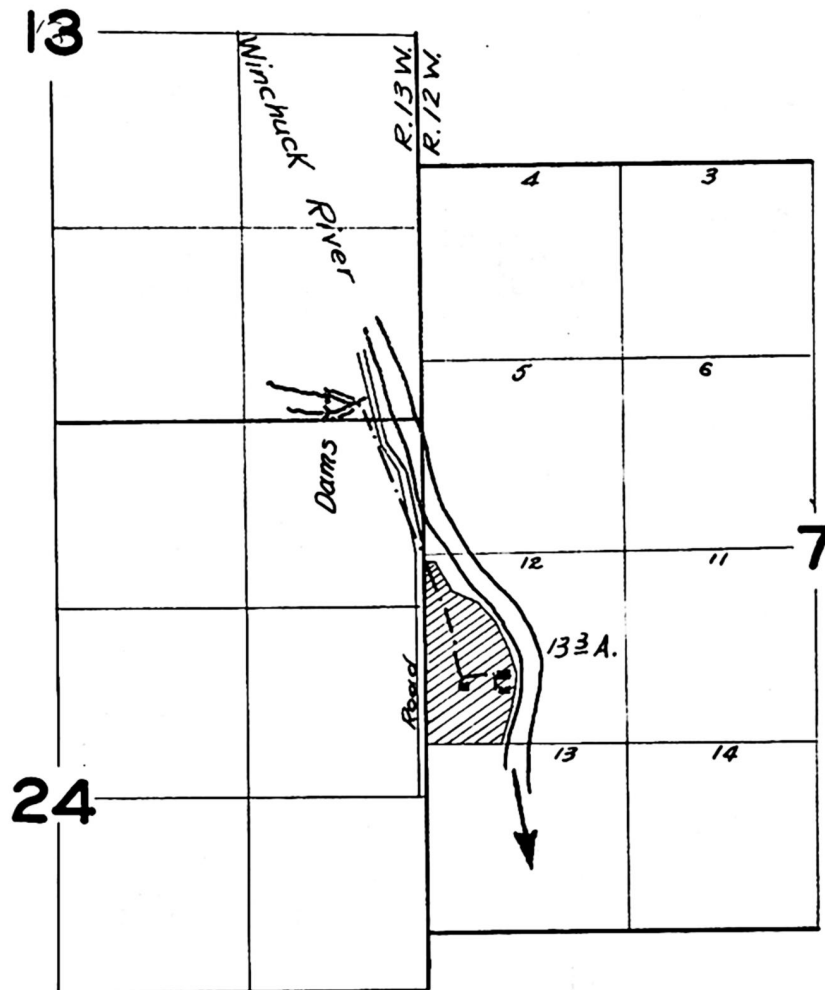

FINAL PROOF SURVEY
UNDER

Application No. 23949..... Permit No. 18907....
IN NAME OF

..... Leland W. Pettegrew

Surveyed Sept. 21, 1953., by H. L. Coffman....