


T. 4 S., R. 1 E., W.M.

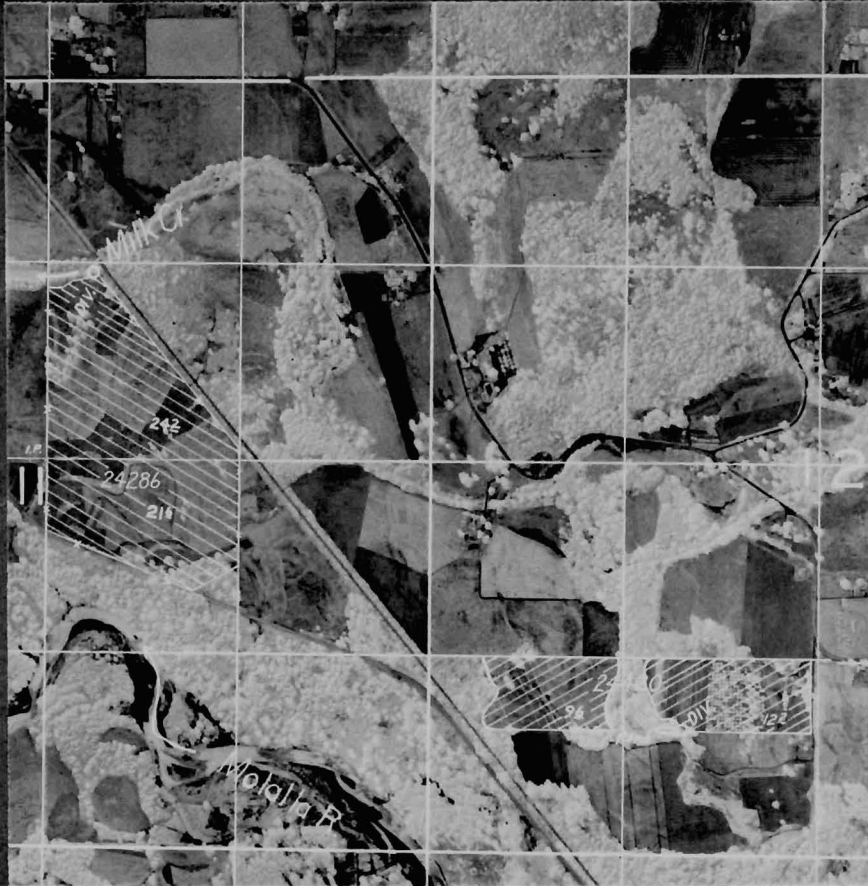

FINAL PROOF SURVEY

UNDER

21420

19258

Application No. 24286 Permit No. 19153

IN NAME OF

D. W. CUTSFORTH

ELWOOD FAIST

May 27

Surveyed July 7, 1953, by H. L. Coffman.

DFK-3D-83