


24379

T. 4 S., R. 1 E., W.M.

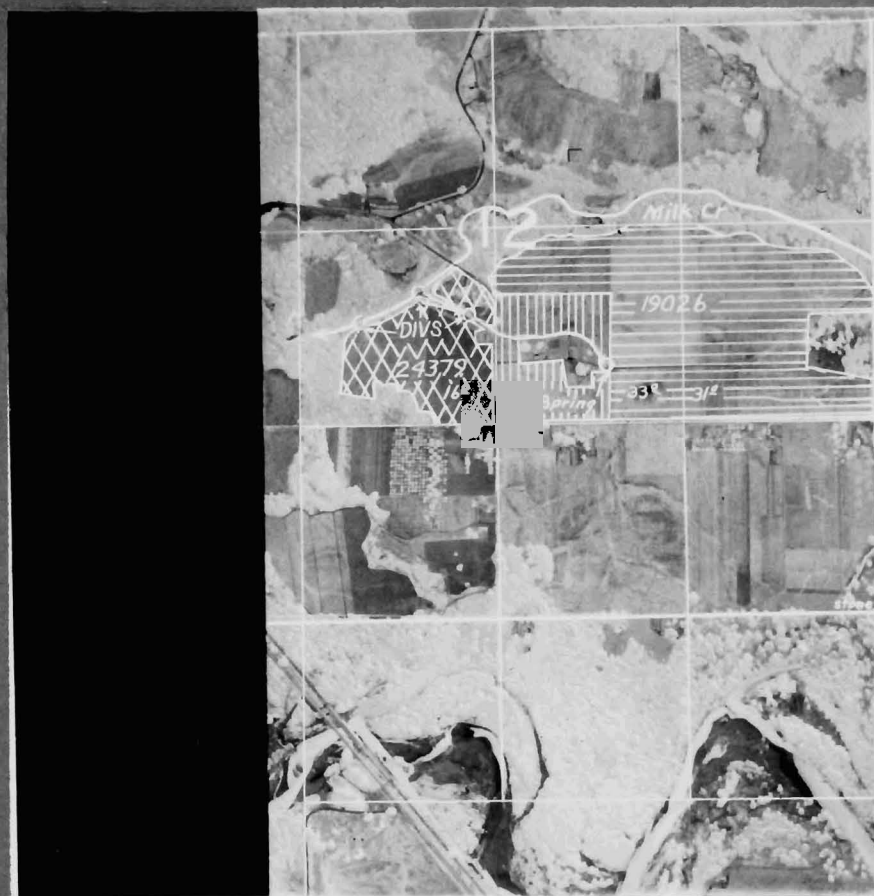

FINAL PROOF SURVEY

UNDER

Application No. 19026 24379 Permit No. 14633 19145

IN NAME OF
L. RUTHERFORD
FRANK SPERB

Surveyed May 26 1953, by H. L. Coffman

DFK-3D-121