


T. 4 S., R. 1 E., W.M.

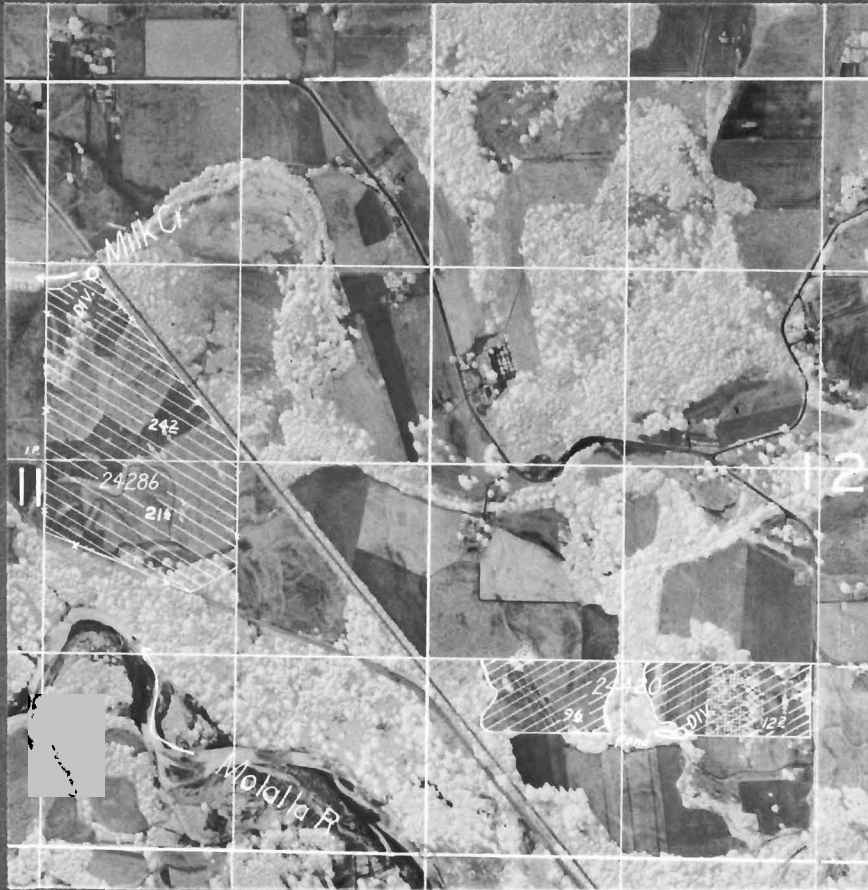

FINAL PROOF SURVEY

UNDER

24420

19258

Application No. 24286 Permit No. 19153

IN NAME OF

D. W. CUTSFORTH

ELWOOD FAIST

May 27

Surveyed July 7, 1953, by H. L. Coffman.