


24529

T. 27 S., R. 7 W., W. M.

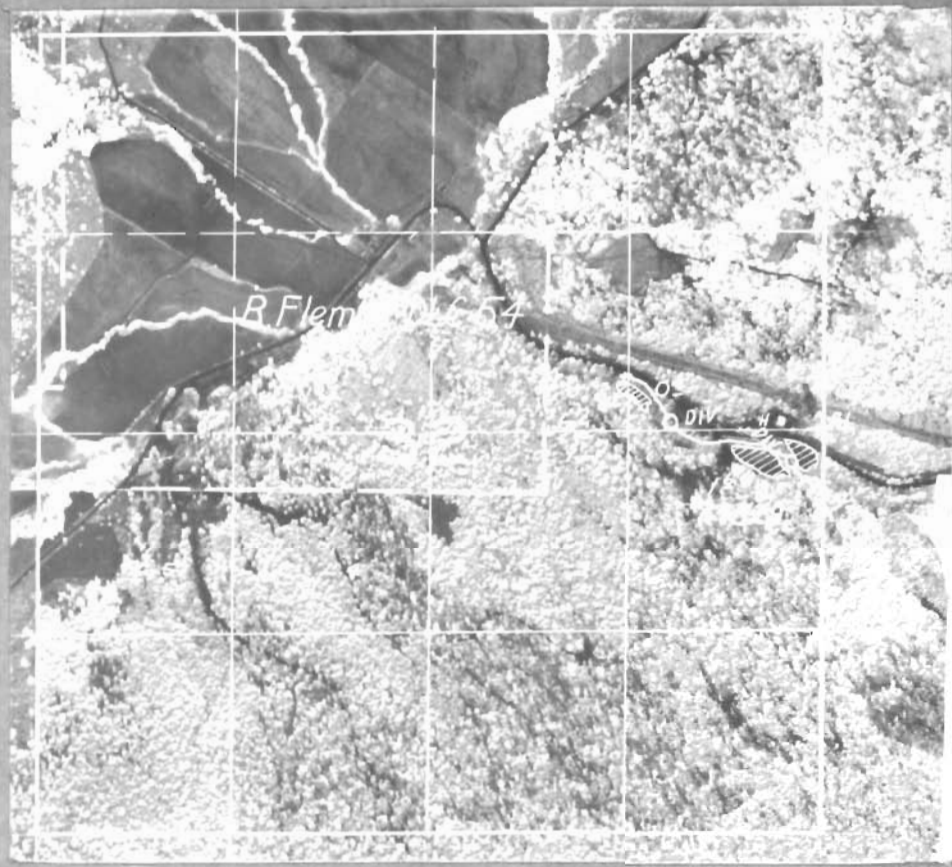

FINAL PROOF SURVEY
 UNDER

Application No. 24529 Permit No. 19313
 IN NAME OF

ALBERT STINGLEY

Surveyed May 14 1953, by H. L. Coffman

DB-HW-12-115