
T. 4 S., R. 1 E., W.M.

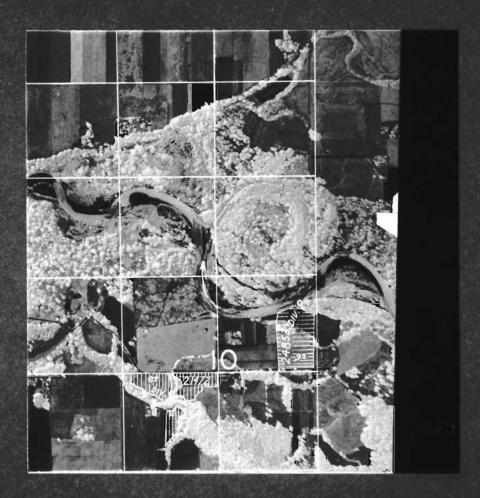

## FINAL PROOF SURVEY

UNDER 21472

16842

Application No. 24853 Permit No.19560
IN NAME OF
FRED C. MILLER

JOSEPH OTTO DASSO

July 6

Surveyed July 7 1953, by H. L. Coffman