
T.4 S ., R. 2 E., W.M.

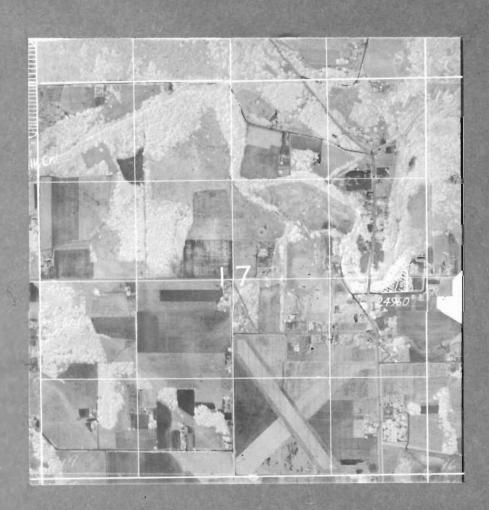

## FINAL PROOF SURVEY

UNDER

Application No. 24960 Permit No. 19604 IN NAME OF

JAMES F. HANHART

Surveyed May 22 19 53, by H. L. Coffman