


T.30 S.R.15W.W.M.

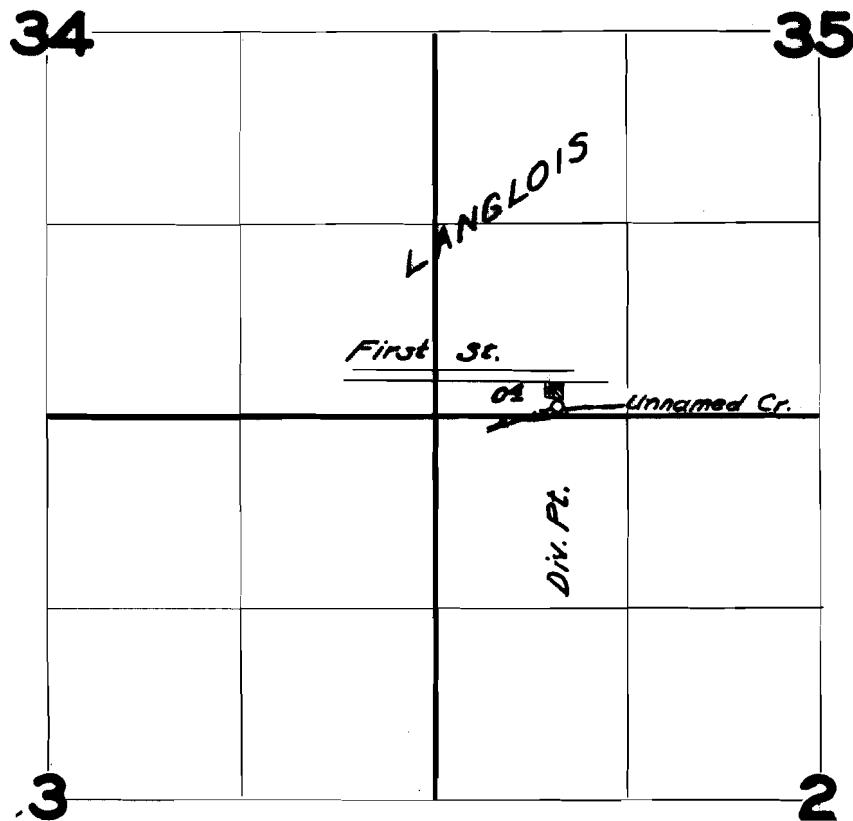

FINAL PROOF SURVEY

UNDER

Application No. 24301 Permit No. 19124

IN NAME OF

Paul Smith

Surveyed Sept 24 1953, by H.L. Coffman

1953-D