


24506

T. 29 S., R. 4 W., W. M.

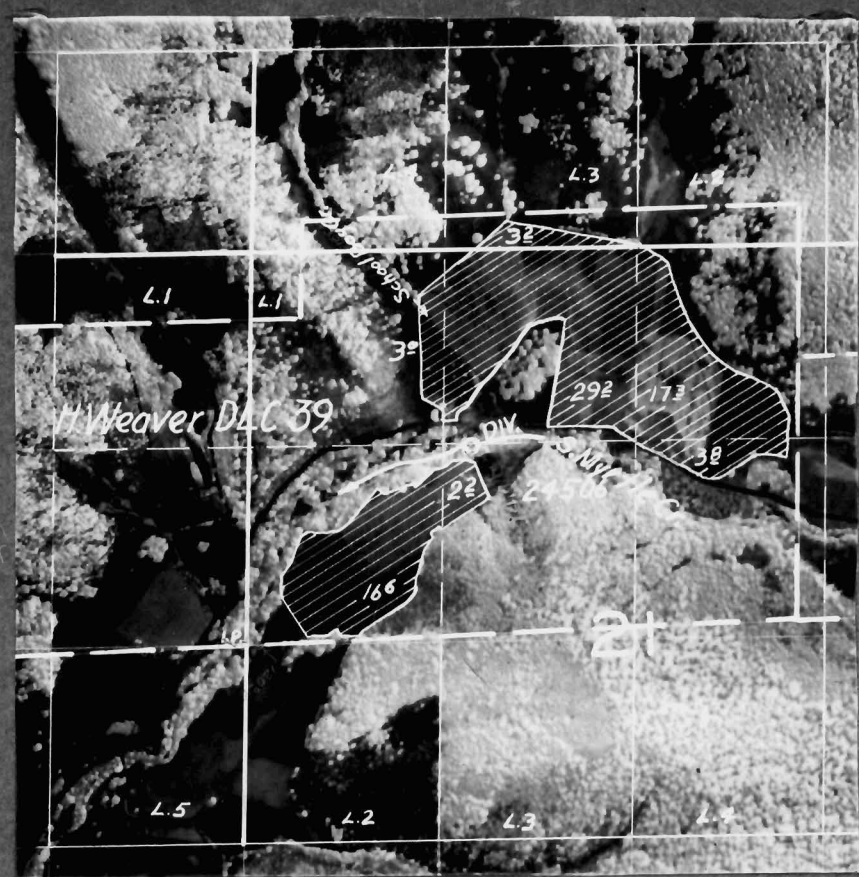

# FINAL PROOF SURVEY

UNDER

Application No. 24506 Permit No. 19302

IN NAME OF

HOWARD L. BROWNSON

Surveyed May 6 1953, by T. Jones