


# T.41 S.R.13 W.W.M.

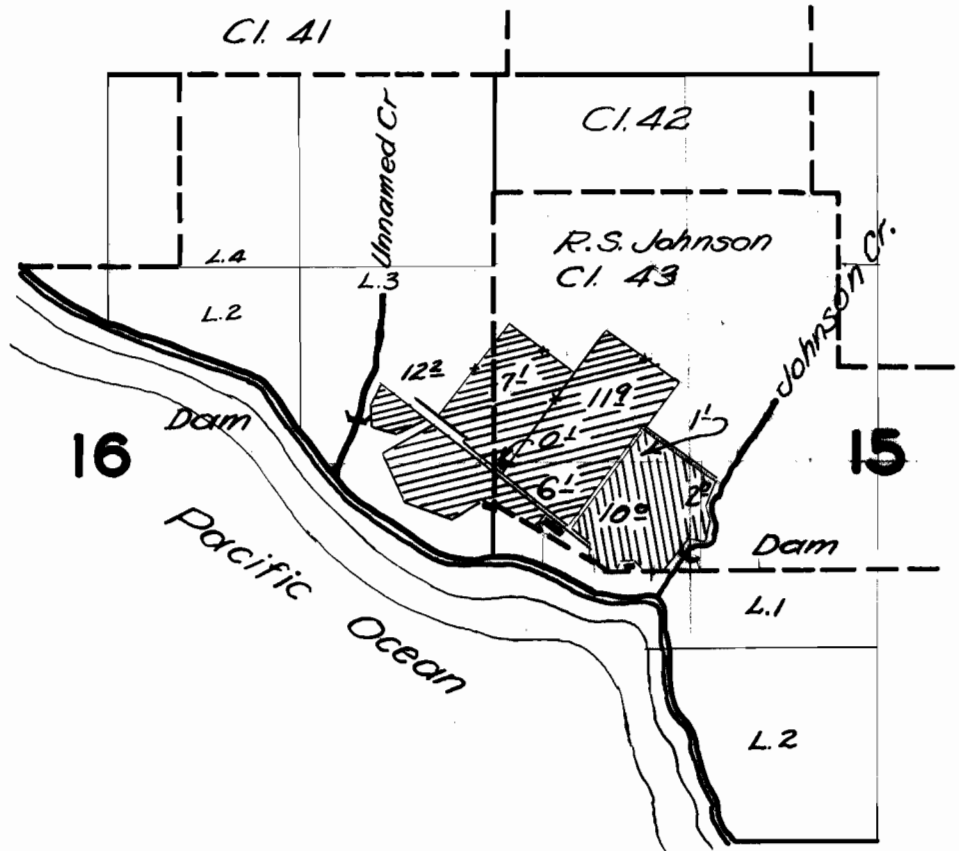

App. 24740 Permit 19506  
 App. 25014 Permit 19709



## FINAL PROOF SURVEY

UNDER

24740

19506

Application No. 25014 Permit No. 19709

IN NAME OF

Ray Springer and R.L. Oliver

A.K. Hastings

Surveyed Sept. 19, 1953, by H.L. Hoffman