


T12 S., R.5 W., W.M.

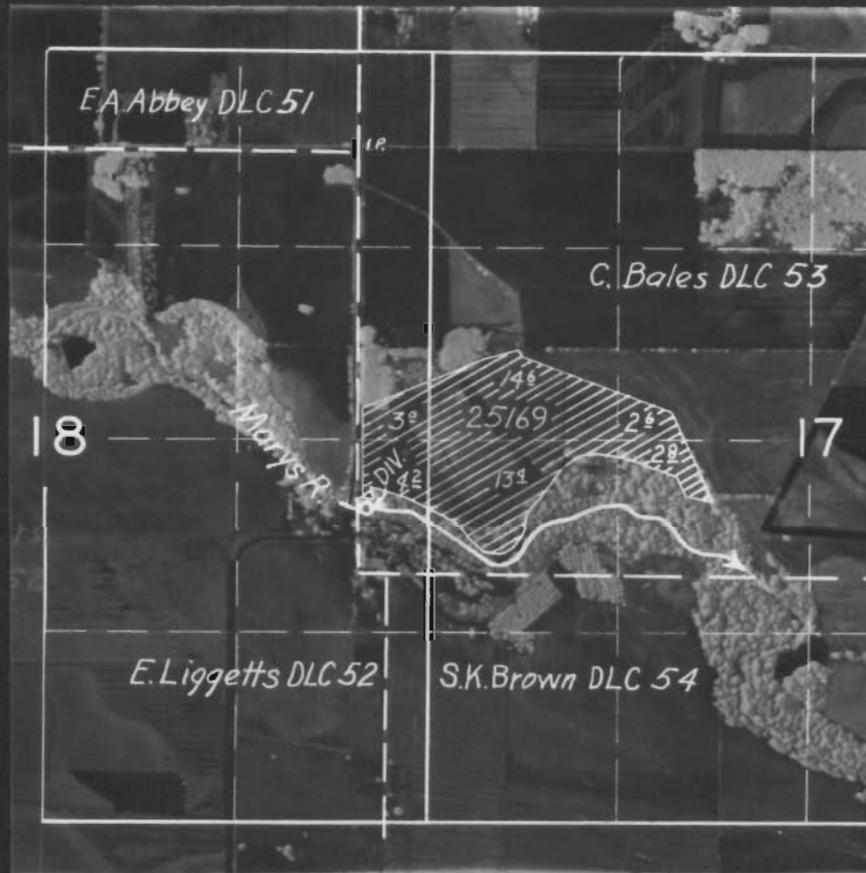

**FINAL PROOF SURVEY**  
UNDER

Application No. 25169 Permit No. 19793  
IN NAME OF

Ben Ellis

Surveyed Aug. 27, 1953, by H.L. Coffman

DFJ-4D-132