


T. 2 S., R. 3 E., W.M.

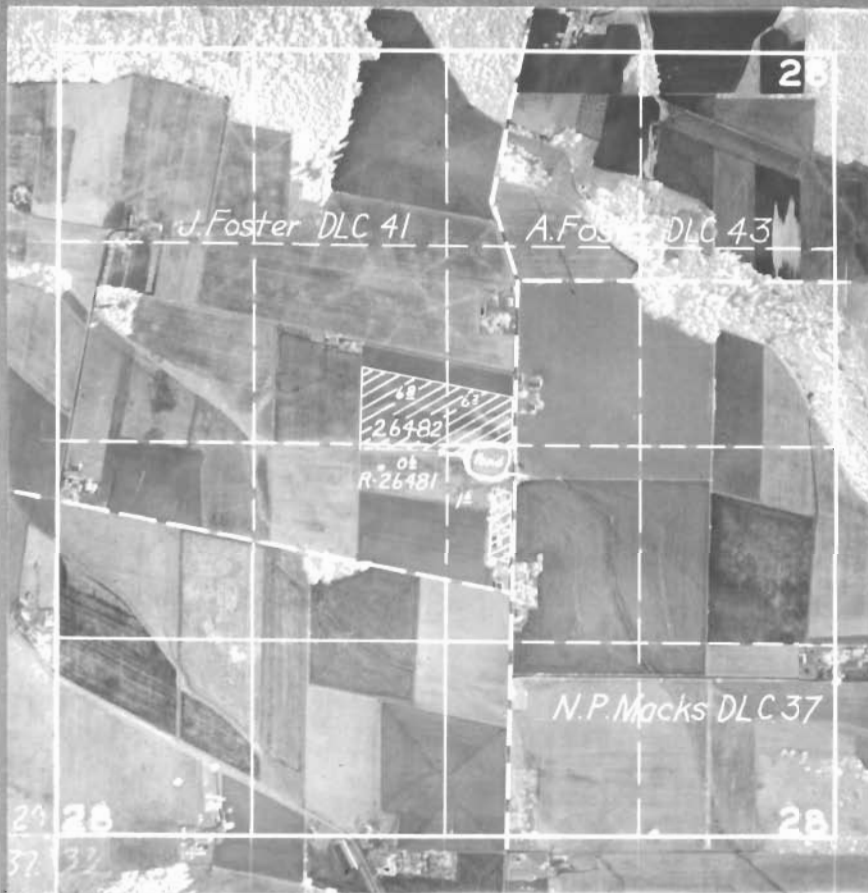

FINAL PROOF SURVEY
UNDER

Application No. 26482 Permit No. 20756
IN NAME OF

ALBERT GERBER

Surveyed August 3 1953, by T. Jones

DFK-1D-133