


T.40S.R.14WWM

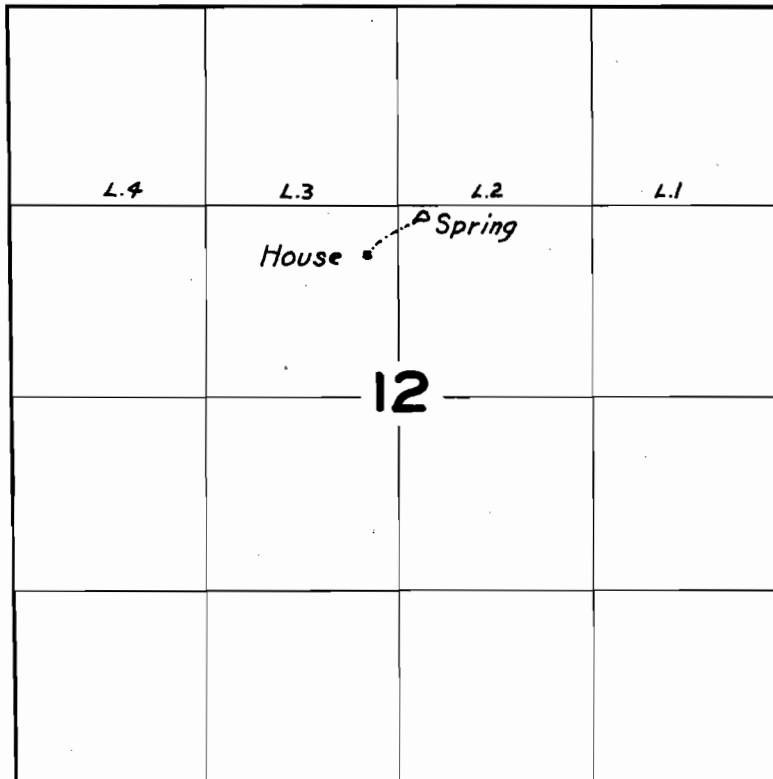

FINAL PROOF SURVEY
UNDER

Application No. 26562 Permit No. 20813

IN NAME OF

Wm. H. Smith

Surveyed Sept. 17 1953 by T. Jones